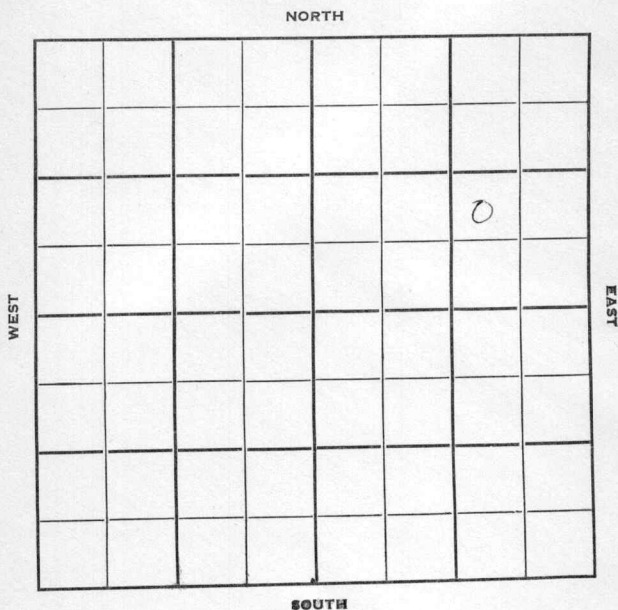


Section 11 Township 23 Range 13EWell No. #1 K. I. LudhiCompany Payrock Oil

KANSAS

Coffey

Sec. 11 Twp. 23 R. 13-E

Well No. #1 K I Ludhi Farm

Payrock Oil Company

Contractor

Miscellaneous


Ft. from N. Line

990 Ft. from S. Line

990 Ft. from E. Line

Ft. from W. Line

NORTH

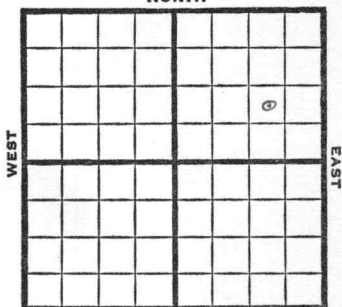

SOUTH

NW SE NE

1950

REPORT

2/15 Spud 2-9-50
Drlg 350'

3/29 TD 1796'
10"@ 750'
4"@ 1789'
Miss 1760'
20 BOPD
Comp

COMPLETED

Map No. _____ Sec. 11 Twp. 23 R. 13EWell No. 1 K. I. LudhiPayrock Oil

Company

Contractor

NW SE NE

SECTION PLAT



_____ Ft. from N. Line

990 Ft. from S. Line990 Ft. from E. Line

_____ Ft. from W. Line

Coffey County

Location _____

Rig up _____

Drilling and Remarks:

Spud 2-9-50

drlg. 350

RECORD

Cased _____ in., _____ ft.

Sand _____

Gas _____

Oil _____

Total Depth _____

PRODUCTION

1st 24 hrs. Nat. _____

1st 24 hrs. after shot _____

Gas _____ Cu. Ft.

Dry Hole _____

Abandoned _____

Date

FEB 15 1950 19J. E. TYRA

Scout

Map No. _____ Sec. 11 Twp. 23 R. 13EWell No. 1 K. I. Ludhi

Payrock _____ Company

Contractor


NW SE NE

E1.
SECTION PLAT

_____ Ft. from N. Line

990 Ft. from S. Line990 Ft. from E. Line

_____ Ft. from W. Line

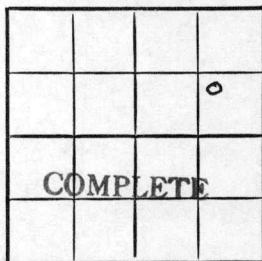

Coffey County

Location _____

Rig up _____

Drilling and Remarks:

*10" @ 750**4" @ 1789**miss 1760**20 BOPD*

RECORD

Cased _____ in., _____ ft.

Sand _____

Gas _____

Oil _____

Total Depth 1796

PRODUCTION

1st 24 hrs. Nat. _____

1st 24 hrs. after shot _____

Gas _____ Cu. Ft.

Dry Hole _____

Abandoned _____

Date

MAR 29 1950

19

J. E. TYRA

Scout