

Well No. 3 Oliver Farm

Arnold & Day Company

WEST

EAST

SOUTH

FIRST REPORT

Rig Up-----

Drilling Remarks:

PRODUCTION

1st 24 hrs. Nat. -----

1st 24 hrs. after shot-----

Gas -----cu. ft.

Dry Hole_____

Abandoned_ _ _ _ _

Map No. 11 Sec. 14 Twp. 23 R. 13


Well No. 3 Chinger Farm
Arnold & Day Company
NORTH

1120 Ft. from N. Line

Ft. from S. Line

Ft. from E. Line

200 Ft. from W. Line

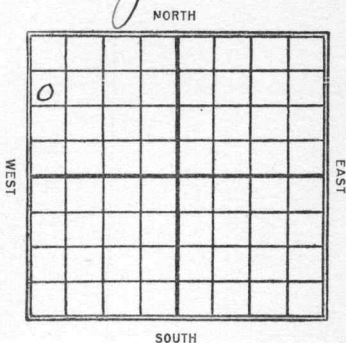

Date _____

REPORT

Date
1922

11/24
1923

1923

1/6	Sand 1803-29- Shot 40 gts. 10 Bbls.
-----	--

Map No. **KANSAS** ¹⁷ Sec. **14** Twp. **23** R. **13**
 Well No. **3 - Olinger**
Ronald & Hay Company
 Contractor

FIRST REPORT

SECTION PLAT

1120 Ft. from N. Line

_____ Ft. from S. Line

_____ Ft. from E. Line

200 Ft. from W. Line

0			

Location _____

Rig up _____

Drilling and Remarks:

20.880

20.1410

RECORD

Cased _____ in., _____ ft.

Sand _____

Gas _____

Oil _____

Total Depth _____

PRODUCTION

1st 24 hrs. Nat. _____

1st 24 hrs. after shot _____

Gas _____ Cu. Ft.

Dry Hole _____

Abandoned _____

Date

NOV 24 1922

M. A. BENEAR

_____ 191 _____

Scout

Map No. **KANSAS** *17* Sec. *14* Twp. *23* R. *13*Well No. *3 Olinger**Ronald & Leary* Company

Contractor

COMPLETED

SECTION PLAT

1120' Ft. from N. Line

Ft. from S. Line

Ft. from E. Line

200' Ft. from W. Line

<i>0</i>			

RECORD

Location

Cased _____ in., _____ ft.

Rig up

Sand _____

Drilling and Remarks:

Gas _____

Oil _____

Total Depth _____

*Top line 1785**S. 1803-29**shot 40 ft**10 lbs*

PRODUCTION

1st 24 hrs. Nat. _____

1st 24 hrs. after shot _____

Gas _____ Cu. Ft.

Dry Hole _____

Abandoned _____

Date

JAN 6 1923

M. A. BENEAR

191

Scout