

Section 30 Township 28 Range 1EWell No. #1 RichmondCompany Beardmore Drlg.

NORTH

0							

WEST

EAST

SOUTH

Sedgwick

KANSAS

SEC.	TWP.	R.
30	28	1 E

WELL NO.

4 Richmond

FARM

COMPANY

Beardmore Drlg.

CONTRACTOR

Co. tools

Gladys Pool


Ft. from N. Line

Ft. from S. Line

Ft. from E. Line

Ft. from W. Line

SW SW NW

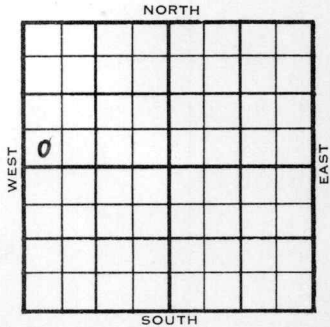

1955

ELEVATION

1272'

REPORT

3/2

Spud 2-24-55

8-5/8" @ 125

Drlg. 1680'

3/23

Spud 2-24-55, oil well, TD 3207

8 5/8" @ 125 KC 2646, Miss 3153

TD 3206, 5" @ 3198, CO to 3206,

DE 3207, 2500 A F/12 BOPH

Comp. F/316 BOPD

COMPLETED

County Sedgwick State KansasSec. 30 (Blk. 28 (Sur. 1E Map No.Operator Beardmore Drlg.Well No. 4 Farm RichmondElev. Location SW SW NW


330 Ft. From S Line NW330 Ft. From W Line Quarter1st. Report MAR 2 1955

Completion

Remarks

Co. toolsSpudding Date 2-24-55Drlg. Data Gladys Pool8 5/8" @ 125 drlg. 1680

FABEN GILSTRAP

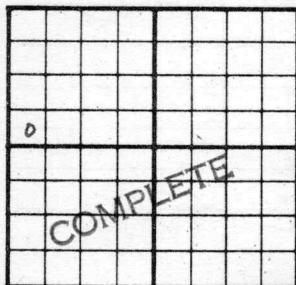County Sedgwick State KansasSec. 30 (Blk.
Twp.) 28 (Sur.
Rge.) 1E Map No.Operator Beardmore Drlg.Well No. 4 Farm RichmondElev. 1272 Location SW SW NW330 Ft. From S Line NW330 Ft. From W Line Quarter1st. ReportCompletion MAR 23 1955Remarks Gladys PoolCo. toolsSpudding Date 2-24-55Drlg. Data Oil well TD 32078 5/8" @ 125 KC 2646 Miss. 3153TD 3206 5" @ 3198 CO to 3206D^D 3207 2500 A F/ 12 bophComp. F/ 316 bopd

FABEN GILSTRAP