


Section 30 Township 28 Range 1 EWell No. # 3 RichmondCompany Beardmore-Sutton

NORTH

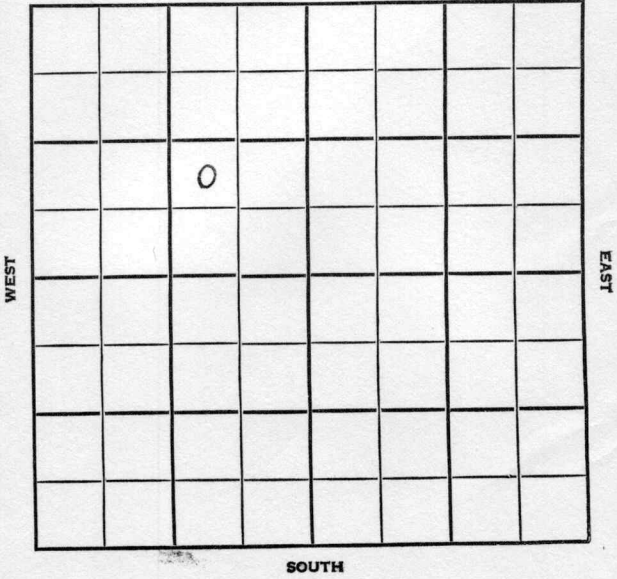

Sedgwick KANSAS

SEC.	TWP.	R.
30	28	1E

WELL NO.

3 Richmond

FARM

COMPANY

Beardmore-Sutton

CONTRACTOR

Co. tools


Gladys Pool

Ft. from N. Line

990 Ft. from S. Line

990 Ft. from E. Line

Ft. from W. Line

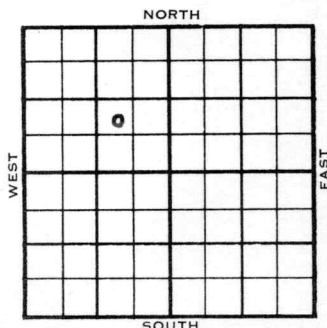

NW SE NW

1955

ELEVATION

1275'

REPORT

1/5

C&P

3/2

Spud 1-8-55 Oil well TD 3160
8" @ 157 Miss 3130 TD 3155
5" @ 3139 DD 3160 1000 A
F/15 BOPH Comp. F/797 BOPD

COMPLETED

County Sedgwick State KansasSec. 30 (Blk.) 28 (Sur.) 1E Map No.Operator Beardmore-SuttonWell No. 3 Farm RichmondElev. Location NW SE NW

		0					

990 Ft. From S Line NW990 Ft. From E Line Quarter1st. Report 1AN 5 1955

Completion

Remarks

Spudding Date

Drlg. Data Gladys PoolCellar & pits

FABEN GILSTRAP

