


Section 30 Township 28 Range 1E
Well No. #6 Richmond
Company Beardmore Drlg.

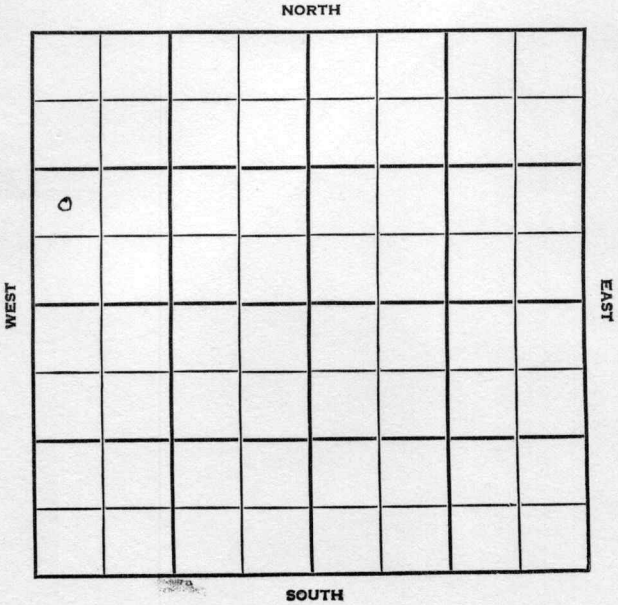

Sedgwick KANSAS

SEC.	TWP.	R.
30	28	1E

WELL NO.

6 Richmond

FARM

COMPANY

Beardmore Drlg.

CONTRACTOR

Co. Tools


Gladys Pool

Ft. from N. Line

990 Ft. from S. Line

Ft. from E. Line

330 Ft. from W. Line

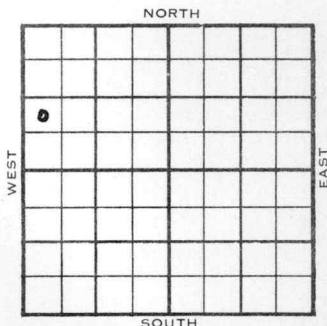

NW SW NW

1955

ELEVATION

1273'

REPORT

4/13

RUR

County Sedgwick State Kansas
Sec. 30 (Blk.) 28 (Sur.) 1E Map No.
(Twp.)
Operator Beardmore Drlg.
Well No. 6 Farm Richmond
Elev. 1273 Location NW SW NW

990 Ft. From S Line NW
330 Ft. From W Line Quarter
1st. Report APR 13 1955

Completion _____

Remarks _____

Co. tools

Spudding Date _____

Drlg. Data

Gladys Pool

RUR

FABEN GILSTRAP