


Section 30 Township 28 Range 1E  
Well No. #7 Richmond  
Company Beardmore Drlg.

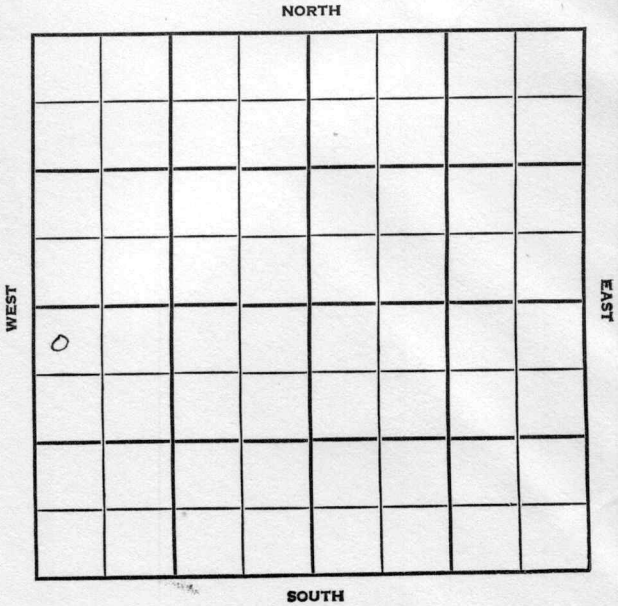

|      |      |    |
|------|------|----|
| SEC. | TWP. | R. |
| 30   | 28   | 1E |

WELL NO.

7 Richmond

FARM

COMPANY

Beardmore Drlg.

CONTRACTOR

Co. Tools


Gladys Pool

330 Ft. from N. Line

Ft. from S. Line

Ft. from E. Line

330 Ft. from W. Line

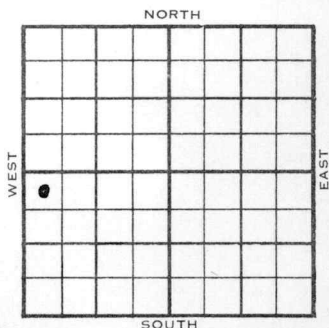

NW NW SW

1955

ELEVATION

1272'

REPORT

4/13

C&amp;P

5/25

Spud 4-19-55 8-5/8" @ 122 w/100  
 Cored 3158-78, rec 18 1/2'  
 Cored 3178-87, rec 9 1/2'  
 Cored 3188-99, rec 11'  
 5 1/2" @ 3193 w/50 CO to 3201  
 FU 1300' oil 12 hr. DD 3203'  
 S/2 1/4 BOPH 3 hr. 2500 A F/12 BOPH  
 Comp. F/606 BOPD  
 Tops: Kans. City 2643', Miss. Dolo  
 3148'.  
 TD 3201' - Comp.

COMPLETED

FABEN GILSTRAP

COMPLETED

FORM 513 REV. SUNRAY

County Sedgwick Elev. 1272  
 Sec. 30 Twp. 28 Rge. 1E  
 Company Beardmore Drlg.  
 Farm Name Richmond No. 7

TOPS

DEPTH

DATUM

Loc. in Section

NW NW SW

Cim. Anhydrite

Ft. Riley

Howard

Topeka

Heebner Sh.

Toronto Ls.

Brown Lime

Lansing

Kans. City

2643

1371

B. K. C.

Congl.

Miss. dol.

3148

1876

Kinderhook

Misener

Hunton

Sylv. Maquo

Viola

Simpson

Smp.

Gorham

Arbuckle

Basal Sand

Pre. Cam.


T. D.

3201

Drlg. Contr.

Pool

Gladys

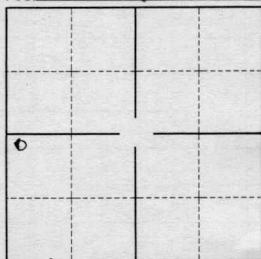

Date Comm.

Date Comp. MAY 25 '55

Spud 4-19-55 8 5/8" @ 122' w/ 100

Cored 3158-78 Rec. 18 1/2'

Cored 3178-87 Rec. 9 1/2'

Cored 3188-99 Rec. 11'

5 1/2" @ 3193 w/ 50 @ to 3201 FU 1300'

oil 12 hr. DD 3203 S/ 2 1/4 boph 3 hr.

2500 A F/ 12 boph

Comp. F/ 606 bopd

3201  
12 1/2  
12 1/2  
12 1/2