


Sedgwick County, Kansas

Section 30 Township 28S Range 1EWell No. #11 RichmondCompany Beardmore Drilling

NORTH

WEST

EAST

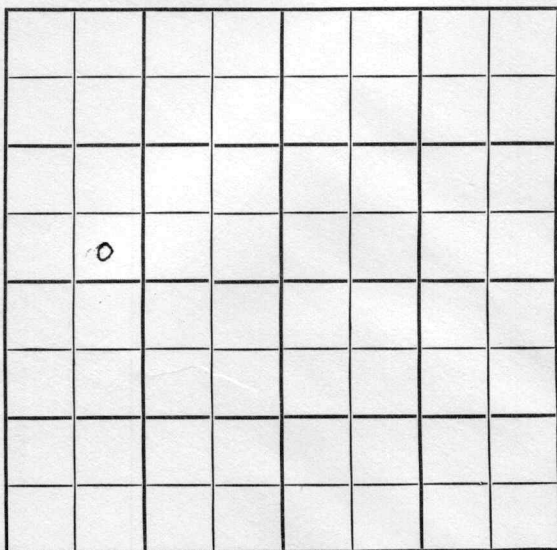

SOUTH

Sedgwick KANSAS

SEC.	TWP.	R.
30	28	1E

WELL NO.

#11 Richmond

FARM

COMPANY

Beardmore Drlg.

CONTRACTOR

Co. Tools


~~Glady~~ Gladys

Ft. from N. Line

Ft. from S. Line

Ft. from E. Line

Ft. from W. Line

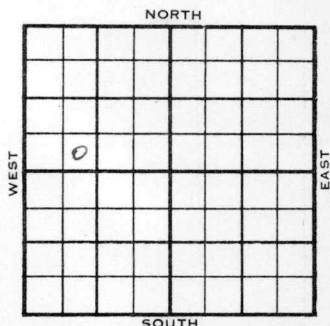

SE SW NW

1955

ELEVATION

1273'

REPORT

8/24

Comm 8-23-55

8" @ 151/115

9-21

5½" @ 3195

CO 3199;

Swb 4 bo plus 5 gw 2 hrs.;

1000 A;

Swb 15 bo plus 10% wtr.

test 5 boph 10% wtr.

pmp 200 bopd 1% wtr.

Tops: K.C. 2638

M. 3165

T.D. 3199'

COMPLETED

County

Sedgwick

Elev.

Sec.

30

Twp.

28

Rge.

1E

Company

Beardmore Drlg.

Farm Name

Richmond

No.

11

TOPS

DEPTH

LOG

DATUM

Loc. in Sec.

Anh.

Tp.

H.

Tr.

Dg.

B.L.

L.

K.C.

B.K.C.

Ce.

C.

M.

M.

K.

Mz.

Mq.

V.

S.

S.

A.

R.

Pc.

G.

T.D.

SE SW NW

Geol.

Contr.

Co. tools

Pool No Pool

Gladys

AUG 24 1955

FIRST REPORT

Date Comm.

8-23-55

8" @ 151/115

County **Sedgwick** Elev. **1273**
 Sec. **30** Twp. **28S** Rge. **1E**
 Company **Beardmore Drlg.**
 Farm Name **Richamond** No. **11**

TOPS	DEPTH	LOG	DATUM	Loc. in Sec.
Anh.				SE SW NW
T.P.				
H.				
Tr.				
Dg.				
BL.				
L.				Geol.
K.C.	2638		1365	Contr.
B.K.C.				Do. tools
Ce.				Pool
C.	3165		1892	Gladys
M.				
M.				
K.				
Mz.				
Mq.				
V.				
S.				
S.				
A.				
R.				
PE.				
G.				
T.D.	3199			

Date Comm. **8-23-55** SEP 21 1955

8" 151 w/115; 5½" 3195; CO 3199; swb 4 bo
 plus 5 gw 2 hrs.; 1000 A; swb 15 bo plus
 10% wtr.; test 5 boph 10% wtr.;
 pmp 200 bopd 1% wtr.