

Sedgwick

KANSAS

SECTION 30 TOWNSHIP 28 RANGE 1 E

WELL NO. #16 Richmond

COMPANY Beardmore Drlg.

NORTH

WEST								EAST

SOUTH

Sedgwick

KANSAS

SEC.	TWP.	R.
30	28	1E

WELL NO.

#16 Richmond

FARM

COMPANY

Beardmore Drig.

CONTRACTOR

Co. Tools

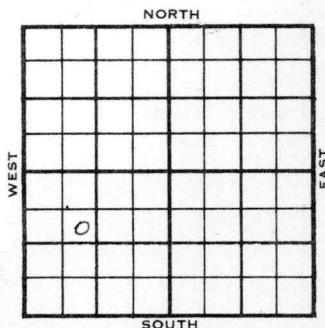
Gladys

Ft. from N. Line

Ft. from S. Line

Ft. from E. Line

Ft. from W. Line

SE NW ~~SW~~ SW

1955	ELEVATION	REPORT
	1273	

11-23 Location

12-28 Comm. 11-27-55
 8 5/8" @ 156/120
 5 1/2" @ 3175/500
 CO to 3187
 DD 3192
 S/ 10 boph
 Comp. 170 bopd
 Lime 3161
 dolo 3175
 TD 3187

COMPLETED

County Sedgwick Elev. _____
 Sec. 30 Twp. 28 Rge. 1E
 Company Beardmore Brlg.
 Farm Name Richmond No. 16

TOPS	DEPTH	LOG	DATUM	Loc. in Sec.
Anh.				SE NW SW
Tp.				
H.				
Tr.				
Dg.				
BL.				
L.				Geol.
K.C.				Contr.
B.K.C.				Co. tools
Ce.				
C.				Pool
M.				Gladys
M.				
K.				
Mz.				
Me.				
V.				
S.				
S.				
A.				
R.				
Pe.				
G.				
T.D.				

FIRST REPORT

NOV 23 '55

Date Comm.

Location

Co.

Lse.

No.

Sec.

T.

R.

County Sedgwick Elev. 1273
 Sec. 30 Twp. 28 Rge. 1E
 Company Beardmore Drilg.
 Farm Name Richmond No. 16

TOPS	DEPTH	LOG	DATUM	Loc. in Sec.
Anh.				SE NW SW
Tr.				
Dg.				
B.L.				
L.				
K.C.				Geol.
B.K.C.				Contr.
Ce.				Co. tools
C.				Pool
M. <u>lime</u>	<u>3161</u>		<u>1888</u>	Gladys
M. <u>dolo</u>	<u>3175</u>		<u>1902</u>	
K.				
Mz.				
Ma.				
V.				
S.				
S.				
A.				
R.				
Pe.				
G.				
T.D.	<u>3187</u>			

Date Comm. 11-27-55 DEC 28 1955

8 5/8" @ 156/120 5 1/2" @ 3175/50

CO to 3187 DD 3192 S/ 10 boph

Comp. 170 bopd

COMPLETE