

Sedgwick

KANSAS

SECTION 30 TOWNSHIP 28 RANGE 1 EWELL NO. #17 RichmondCOMPANY Beardmore Drlg.

NORTH

			0				

WEST

EAST

SOUTH

Sedgwick

KANSAS

SEC. 30	TWP. 28	R. 1E
------------	------------	----------

WELL NO.

#17 Richmond

FARM

COMPANY

Beardmore Drlg.

CONTRACTOR

Co. Tools

Gladys


Ft. from N. Line

Ft. from S. Line

Ft. from E. Line

Ft. from W. Line

NE NE SW

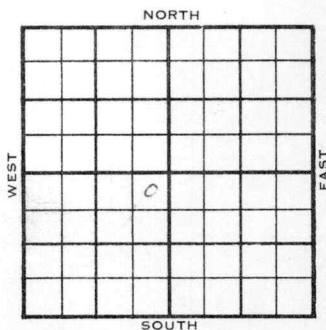

1955

ELEVATION
1272

REPORT

12-7

Comm. 12-4-55
8" @ 155/120
Drlg. 865

1956

1-5

5 $\frac{1}{2}$ " @ 3175/50
DD 3202
~~100~~ 100 A
S/ 2 boph
Comp. 185 bopd
KC 2640
M. 3153
TD 3178'

~~ABANDONED~~

COMPLETED

County Sedgwick Elev. 1272 DF
 Sec. 30 Twp. 28 Rge. 1E
 Company Beardmore Drlg.
 Farm Name Richmond No. 17

TOPS	DEPTH	LOG	DATUM	Loc. in Sec.
Anh.				NE NE SW
TP.				380' NL
H.				
Tr.				
Dg.				
BL.				
L.				Geol.
K.C.				Contr.
B.K.C.				Co. tools
Ce.				Pool
C.				Gladys
M.				
M.				
K.				
Mz.				
Mq.				
V.				
S.				
S.				
A.				
R.				
Pe.				
G.				
T.D.				

FIRST REPORT	
0	
DEC-7-55	

Date Comm. 12-4-55
8" @ 155/120 drlg. 865

County Sedgwick Elev. 1272Sec. 30 Twp. 28 Rge. 1ECompany Beardmore Drlg.Farm Name Richmond No. 17

TOPS	DEPTH	LOG	DATUM	Loc. in Sec.
Anh.				NE NE SW
Tr.				380' NL
H.				
Dg.				
B.L.				
L.				Geol.
K.C.	<u>2640</u>		<u>1368</u>	Contr.
B.K.C.				Co. tools
Ce.				Pool
C.				Gladys
M.	<u>3153</u>		<u>1881</u>	COMPLETE
M.				
K.				
Mz.				
Mq.				
V.				
S.				
S.				
A.				
R.				
Pe.				
G.				
T.D.	<u>3178</u>			

Date Comm. 12-4-55 JAN 5 19568" @ 155/120 5 $\frac{1}{2}$ " @ 3175/50 DD 3202

100 A S/ 2 boph Comp. 185 bopd