

FORM 51 **O.W.W.O.**


Cowley

KANSAS
O.W.W.O.
8/4/14

Section 25 Township 32 Range 4 E

Well No. # 1 Seaman

Company H. H. Blair

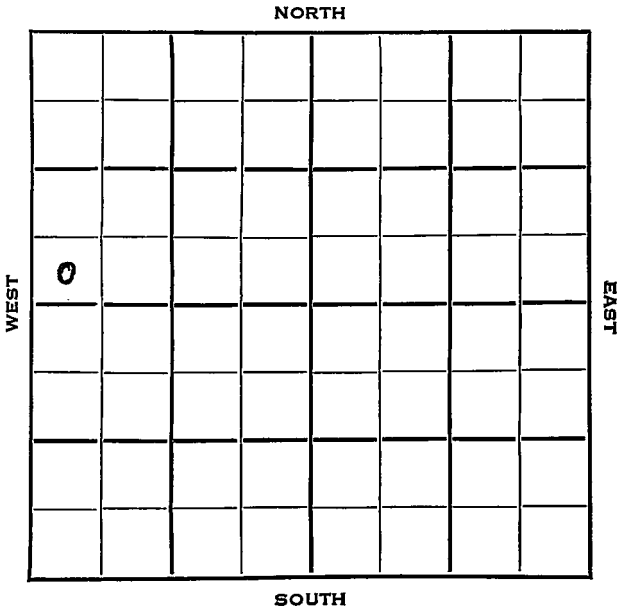

O.W.W.O.

Cowley O.W.W.O.

KANSAS

SEC. 25	TWP.	R.
------------	------	----

WELL NO. #1 Seaman FARM

COMPANY

H H. Blair

CONTRACTOR

KRisswell
~~H. Uhl~~


Winfield Pool

_____ Ft. from N. Line

330 _____ Ft. from S. Line

_____ Ft. from E. Line

330 _____ Ft. from W. Line

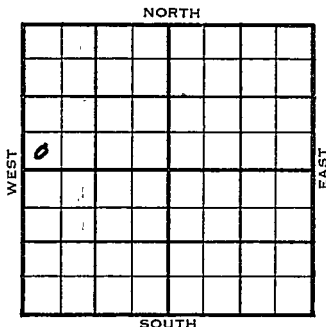

SW SW NW

1953	ELEVATION 1205'	REPORT
------	--------------------	--------

11/24 Location

12/9 Spud 11-25-53
 D&A
 TD 3061'
 8-5/8" @ 94'
 KC 2513', Miss 3045'
 TD 3061'
 D&A

ABANDONED

1954
 5/26 O.W.W.O.
 To CO and run log.

6/23 Oil well
 TD 3061

OVER

County Cowley State Kansas

Sec. 25 (Blk. 32) (Sur. 4E) (Twp.) (Rge.) Map No.

Operator H. H. Blair

Well No. 1 Farm Seeman

Elev. 1205 Location SW SW NW (twin well)

330 Ft. From S Line NW

330 Ft. From W Line Quarter

Ist. Report

Completion DEC 9 1953

Remarks

H. Uhl - Contr.

Spudding Date 11-25-53

Drlg. Data D & A TD 3061

8 5/8" @ 94 KC 2513 Miss. 3045 TD 3061

D & A

O.W.W.O.

County Cowley State Kansas

Sec. 25 (Blk. 32) (Sur. Rge.) 4E Map No.

Operator H. H. Blair

Well No. 1 Farm Seaman

Elev. Location SW SW NW

330 Ft. From S Line NW
 330 Ft. From W Line Quarter

1st. Report

Completion JUN 23 1954

Remarks OWWO O.W.W.O.
Krisswell - Contr.

Spudding Date

Drig. Data Oil well TD 3061

Bart. 2922 TD 3061 5" @ 3041

CO 28/ 2916-24 8/ 2926-28 16/ 2932-36

15/ 2938-42 frac S/ 3 boph P/ 57 bo

Comp. 25 bopd

O.W.W.O.

County **Cowley** State **Kansas**

Sec. **25** (Blk. **32** (Sur. **4E** (Twp. **32** (Rge. **4E** Map No.

Operator **H. H. Blair**

Well No. **1** Farm **Seaman**

Elev. **1205** Location **SW SW NW**

FIRST REPORT COMPLETE

330 Ft. From **S** Line **NW**

330 Ft. From **W** Line **Quarter**

1st. Report **AUG 4 1954**

Completion **AUG 4 1954**

Remarks **O.W.W.O.**

O.W.W.O.

Spudding Date

Drig. Data **Oil well TD 3061**

KC 2513 Miss. 3045 OTD 3061 5" @ 3041

CO to 3061 sd-frac Comp. 30 bopd