


Map No. _____ Sec. 9 Twp. 27 R. 4
 Well No. 3 Anderson Farm _____
Hosden Company _____

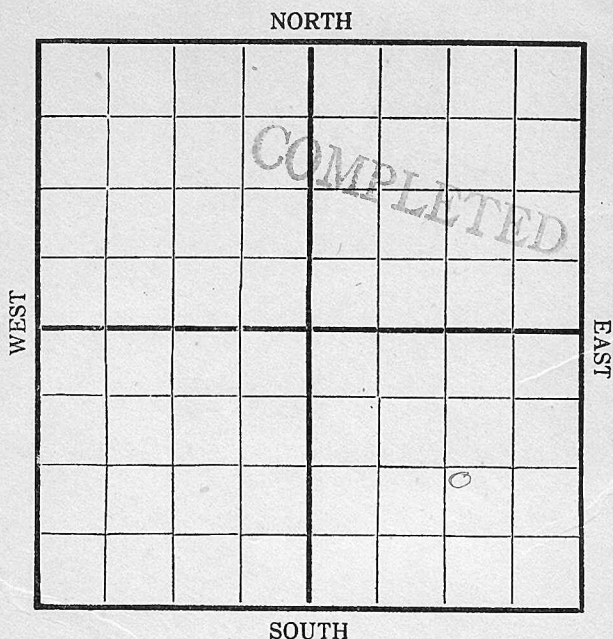

Location _____

Rig Up 10-30-16

Drilling Remarks:

Drilling Remarks:

R 21 = 11/9
Spudling = 11/14
1980 = 11/27
1400 = 12/4
1958 = 12/11
2250 = 12/18

RECORD

Cased _____ in _____ Ft.
 Sand _____
 Gas _____
 Oil _____
 Total Depth _____

PRODUCTION

1st 24 hrs. Nat. _____
 1st 24 hrs. after shot _____
 Gas _____ Cu. Ft.
 Dry Hole _____
 Abandoned _____


Map No. _____ Sec. 9 Twp. 27 R. 4

Well No. 3 Anderson Farm

Anderson Company

NORTH

WEST

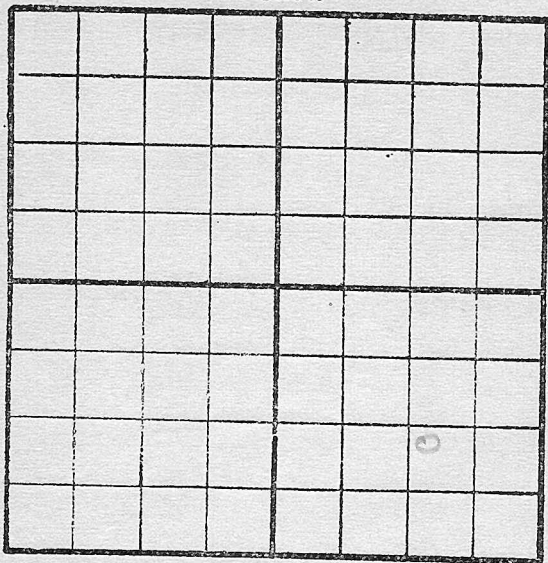

EAST

SOUTH

Location ✓

Rig up ✓

Drilling and remarks:

RECORD

Cased _____ in. _____ Ft.

Sand _____

Gas _____

Oil _____

Total Depth _____

PRODUCTION

1st. 24 hrs. Nat. _____

1st. 24 hrs. after shot _____

Gas _____ Cu. Ft.

Dry Hole _____

Abandoned _____


Date

10/30, 1911, C. Anderson Scout

Map No. _____ Sec. 9 Twp. 27 R. 4
 Well No. 3 Anderson Farm _____
Cosden Company _____

NORTH

WEST

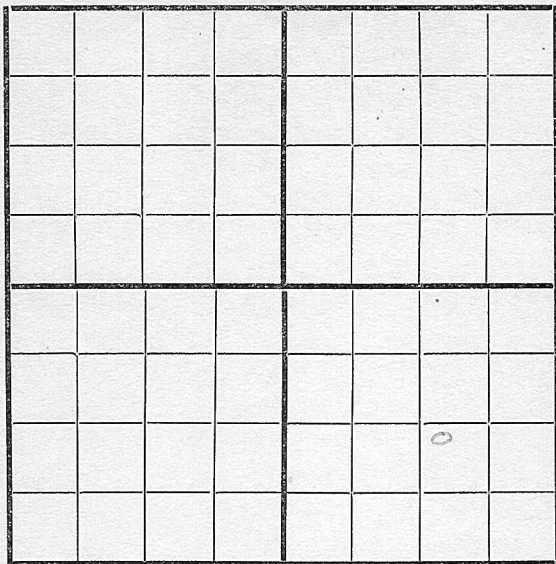

EAST

SOUTH

Location _____
 Rig Up _____
 Drilling and remarks _____

RECORD

Cased _____ in. _____ Ft.
 Sand _____
 Gas _____
 Oil _____
 Total Depth _____

PRODUCTION


1st 24 hrs. Nat. _____
 1st 24 hrs. after shot _____
 Gas _____ Cu. Ft.
 Dry Hole _____
 Abandoned _____

Date

11/9, 1916 Anderson Scout

Map No. _____ Sec. 9 Twp. 27 R. 4
 Well No. 3 _____ Farm _____
 _____ Company

NORTH

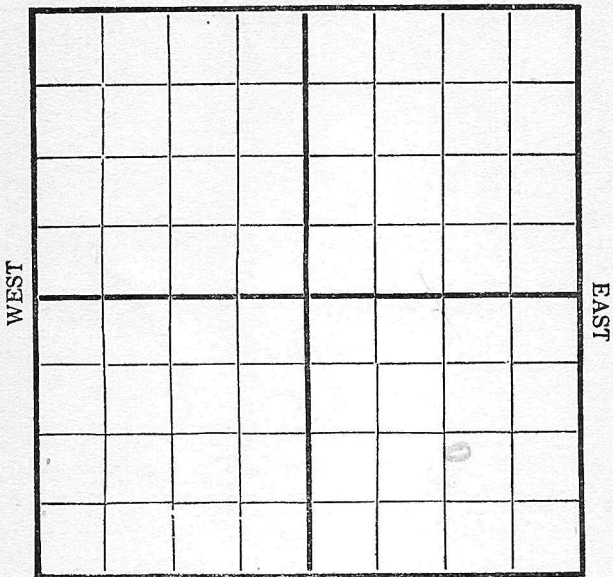

SOUTH

Location _____
 Rig Up _____
 Drilling and remarks

Spending

RECORD

Cased _____ in. _____ Ft.
 Sand _____
 Gas _____
 Oil _____
 Total Depth _____

PRODUCTION


1st 24 hrs. Nat. _____
 First 24 hrs. after shot _____
 Gas _____ Cu. Ft.
 Dry Hole _____
 Abandoned _____

Date

1/14, 1916 *Carley* Scout

Map No. _____ Sec. 9 Twp. 27 R. 4
 Well No. 3 Anderson Farm _____
Co. Co. Company _____

NORTH

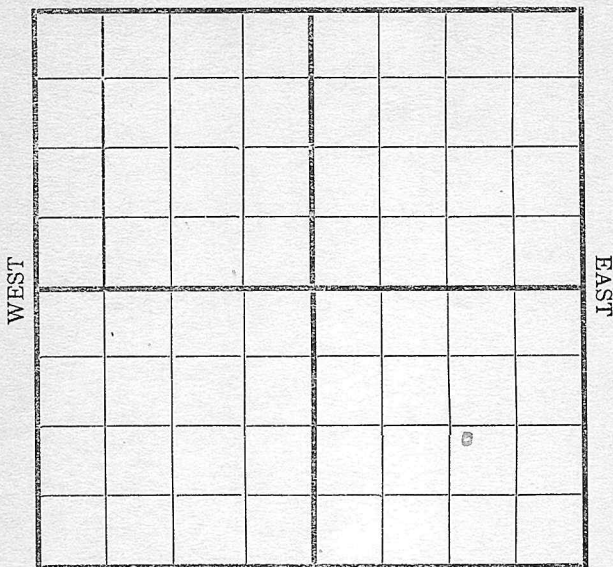

SOUTH

Location _____

Rig Up _____

Drilling and remarks

550

RECORD

Cased _____ in. _____ Ft.

Sand _____

Gas _____

Oil _____

Total Depth _____

PRODUCTION

1st 24 hrs. Nat. _____

1st 24 hrs. after shot _____

Gas _____ Cu. Ft.

Dry Hole _____

Abandoned _____

Date

11/30, 1916 Co. Co. Scout _____

Map No. _____ Sec. 9 Twp. 27 R. 4
 Well No. 3 Anderson Farm _____
Cosden Company _____

NORTH

WEST

EAST

SOUTH

Location _____
 Rig Up _____
 Drilling and remarks

RECORD

Cased _____ in. _____ Ft.
 Sand _____
 Gas _____
 Oil _____
 Total Depth _____

PRODUCTION

1st 24 hrs. Nat. _____
 1st 24 hrs. after shot _____
 Gas _____ Cu. Ft.
 Dry Hole _____
 Abandoned _____

Date


11/27 191 6 Cosden Scout

Map No. _____ Sec. 9 Twp. 27 R. 4Well No. 3 Anderson FarmCosden Company

NORTH

WEST

EAST

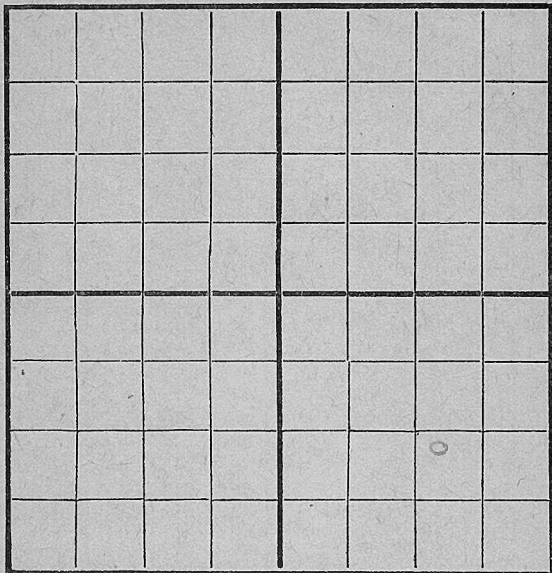

SOUTH

Location _____

Rig Up _____

Drilling and remarks

1400'

RECORD

Cased _____ in. _____ Ft.

Sand _____

Gas _____

Oil _____

Total Depth _____

PRODUCTION

1st 24 hrs. Nat. _____

1st 24 hrs. after shot _____

Gas _____ Cu. Ft.

Dry Hole _____

Abandoned _____


Date

12/4, 1916, Carby Scout

Map No. _____ Sec. 9 Twp. 27 R. 4
 Well No. 3 Anderson Farm _____
Cooper Company _____

NORTH

WEST

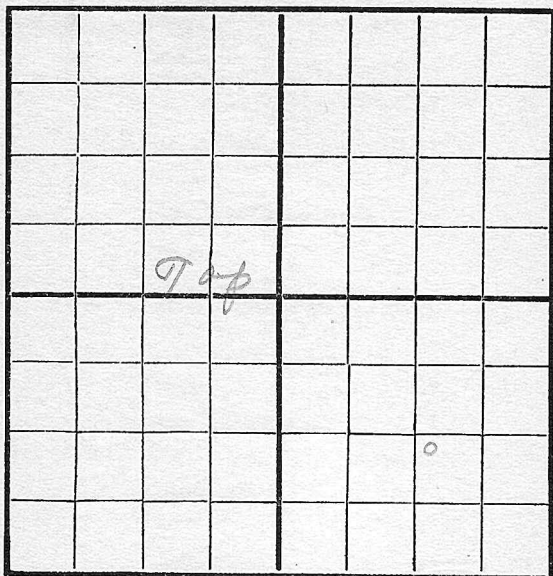

EAST

SOUTH

RECORD

Location _____

Cased _____ in. _____ Ft.

Rig Up _____

Sand 1958'

Drilling and remarks

Gas _____

Oil _____

Total Depth _____

PRODUCTION

1st 24 hrs. Nat. _____

1st 24 hrs. after shot _____

Gas _____ Cu. Ft.

Dry Hole _____

Abandoned _____


Date

12/11, 1916, Cooper Scout

Map No. _____ Sec. 9 Twp. 22 R. 4
 Well No. 3 Anderson Farm
Cosden Company

NORTH

WEST

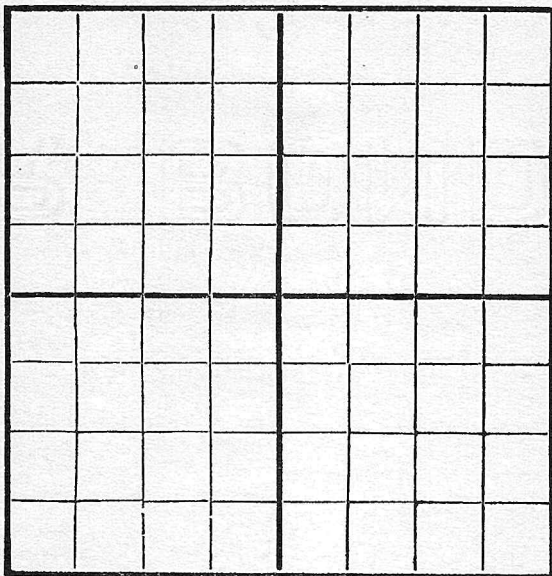

EAST

SOUTH

Location _____

Rig Up _____

Drilling and remarks

2250'

RECORD

Cased _____ in. _____ Ft.

Sand _____

Gas _____

Oil _____

Total Depth _____

PRODUCTION

1st 24 hrs. Nat. _____

1st 24 hrs. after shot _____

Gas _____ Cu. Ft.

Dry Hole _____

Abandoned _____

Date


12/181916Cordell

Scout

Map No. Augusta Sec. 9 Twp. 22 R. 4
 Well No. 3 Anderson Farm
Condon Company

NORTH Kansas

WEST

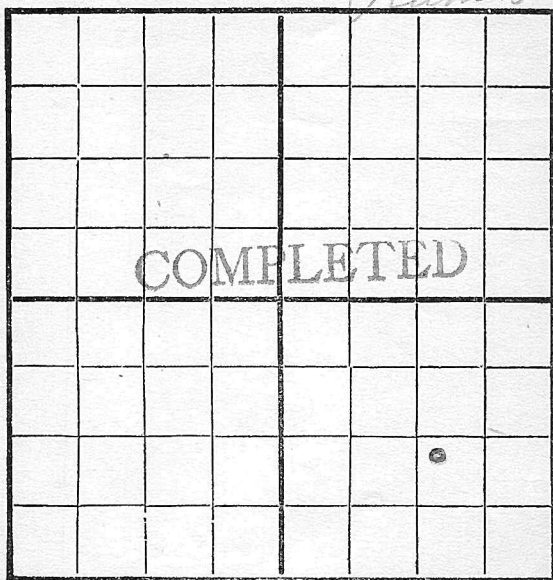

EAST

SOUTH

Location _____

Rig Up _____

Drilling and remarks

Estimates
it at 200
Bbls

RECORD

Cased _____ in. _____ Ft.

Sand 2384-2400

Gas _____

Oil _____

Total Depth _____

PRODUCTION

1st 24 hrs. Nat. _____

First 24 hrs. after shot _____

Gas _____ Cu. Ft.

Dry Hole _____

Abandoned _____

Date

12/28, 1916 Condon Scout