


SEC. 9 TWP. 27 RG. 4
 #1 Anderson FARM
 Kansas. CO.

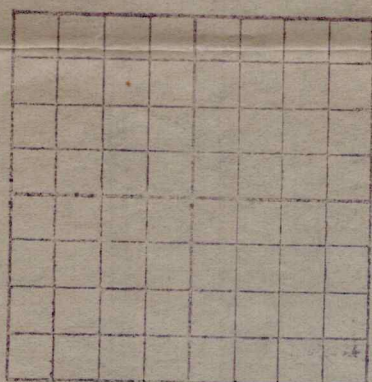

COMPANY: MAMANN

DRILLER:

DRILLING COM.

DRILLING COMP.

CASING RECORD: 12 1/2" at 490'
 10 1157'
 8 1/4 1890'

All Casing left in well.

STRATA	THICKNESS	TOTAL DEPTH.
Lime	85	85
Red Rock	85 to	90
Lime	150	525 Full Water
Red Rock	540	548
Lime	650	665 Full Water.
Sand Water	675	1040
	1095	1115 Full Water.
Lime	1110	1130
Gas Sand	1220	1250 Good showing.
Lime	1250	1300
Hard Lime	1300	1675
Sand Oil	1675	1690 Small Shwoing
Lime	1690	1735 Full Water
Sand Water	1735	1755
Lime	1755	1770
Sand water	1770	1792
Lime	1792	1835
Slate	1835	1962
Sand(Oil) <u>Good</u>	1962	2013 Good showing Oil

Copied

Record of Anderson Well No. 1 in Sec.9-27-4 - Kansas.

Copied from McMan record by L.C.Cardiff June 16, 1916.

- - - - -

Lime	83---85	
Red Rock	85---90	
Lime	150--525	- Hole full of water
Red Rock	540--548	
Lime	650--665	- Hole full of water
Sand Water	675-1040	
	1095-1115	- Hole full of water
Lime	1110-1130	
Gas Sand	1220-1250	- Good showing
Lime	1250-1300	
Lime	1300-1675	- Hard
Sand Oil	1675-1690	- Small showing
Lime	1690-1735	- Hole full of water
Sand water	1735-1755	
Lime	1755-1770	
Sand water	1770-1792	
Lime	1792-1835	
Slate	1835-1962	
Sand (Oil) <u>Good</u>	1962-2013	- Good showing of oil

Casing Record:

13 $\frac{1}{2}$	-	-	490	ft
10	-	-	1157	"
8 $\frac{1}{4}$	-	-	1890	" - All casing left in well