
Form 51 5M 2-22 8411

Kansas

Map No. _____ Sec. 24 Twp. 23 R. 10

Well No. 1 Burbett Farm

Tidal Oil Company

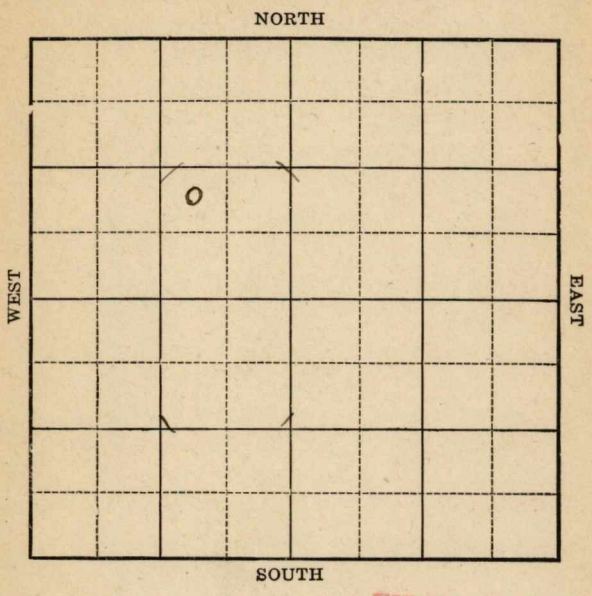

FIRST REPORT

Location _____

Drilling Remarks:

Rig Up COMPLETED

Drilling Remarks:

RECORD

Cased _____ in. _____ ft.

Sand _____

Gas _____

Oil _____

Total Depth _____

PRODUCTION

1st 24 hrs. Nat. _____

1st 24 hrs. after shot _____

Gas _____ cu. ft.

Dry Hole _____

Abandoned _____

Form 252A 8M-11-20 PALACE-TULSA 4617

Map No. _____ Sec. 24 Twp. 23 R. 10

Well No. 1 Burkett _____ Farm


Tidal Oil _____ Company

_____ Ft. from N. Line

990 Ft. from S. Line

990 Ft. from E. Line

_____ Ft. from W. Line

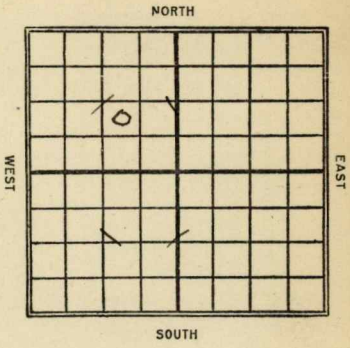

Date 1922	REPORT
10/26	Dlg. 450'
11/4	Sand 2062-2139 Shot 160 qts. 200 Bbls. T.D. 2144'

Form 26—1M—4-19—Mid-West

Map No. K16 Sec. 24 Twp. 23 R. 10

Well No. 1 Burkett

Tidal Oil Company

Contractor

FIRST REPORT


990 Ft. from N. Line

990 Ft. from S. Line

Ft. from E. Line

Ft. from W. Line

SECTION PLAT

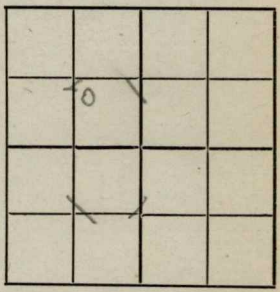

Location

Rig up

Drilling and Remarks:

4650'

RECORD

Cased in., ft.

Sand

Gas

Oil

Total Depth

PRODUCTION

1st 24 hrs. Nat.

1st 24 hrs. after shot

Gas Cu. Ft.

Dry Hole

Abandoned

Date

OCT 26 1922

191

M. A. BENEAR

Scout

Form 26—1M—4-19—Mid-West

16 KANSAS


Map No. _____ Sec. 24 Twp. 23 R. 10

Well No. 1 Burkett

Tidal Company

_____ Contractor

COMPLETED SECTION PLAT

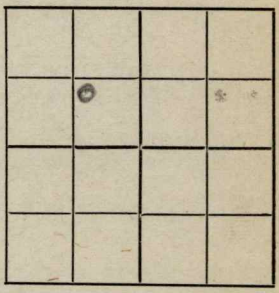

_____ Ft. from N. Line

990 Ft. from S. Line

990 Ft. from E. Line

_____ Ft. from W. Line

Location _____

Rig up _____

Drilling and Remarks:

First sand {2037 2043

shale {2045 2062

shot 160 qts

RECORD

Cased _____ in., _____ ft.

Sand _____

Gas _____

Oil 2062-2139

Total Depth 2144

PRODUCTION

1st 24 hrs. Nat. _____

1st 24 hrs. after shot 200'

Gas _____ Cu. Ft.

Dry Hole _____

Abandoned _____

Date

NOV 24 1922

_____ 191____.

M. A. BENEAR Scout