
Form 51 5M 2-22 8411 Kansas

Map No. _____ Sec. 24 Twp. 23 R. 10

Well No. 1 Burkett Farm

Nye & Basil Company

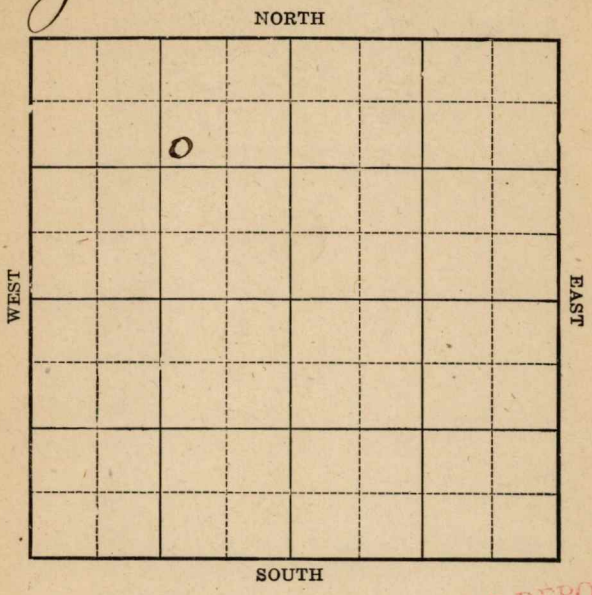

FIRST REPORT COMPLETED

Location _____

Drilling Remarks:

Rig Up _____

Drilling Remarks:

RECORD

Cased _____ in. _____ ft.

Sand _____

Gas _____

Oil _____

Total Depth _____

PRODUCTION

1st 24 hrs. Nat. _____

1st 24 hrs. after shot _____

Gas _____ cu. ft.

Dry Hole _____

Abandoned _____

Form 252A 5M 4-22 8765

Map No. _____ Sec. 24 Twp. 23 R. 10

Well No. #1 Burkett F'arm


Nye & Basel Company

1120 Ft. from N. Line

_____ Ft. from S. Line

1120 Ft. from E. Line

_____ Ft. from W. Line

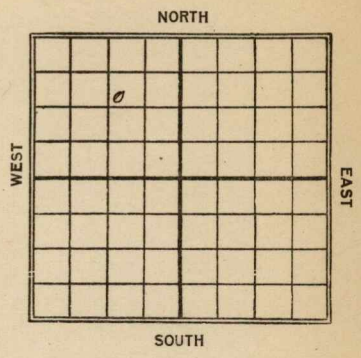

Date 1927	REPORT
8/13	Spudding
10/21	Sand 2080-97 - Sand 2102-33 - Pay - Shot 90 qts. 260 BBls.

Form 26—1M—4-19—Mid-West

Map No. Kan 16 Sec. 24 Twp. 23 R. 10

Well No. 1 Burkett

Nye & Basil Company

Contractor

FIRST REPORT


1120 Ft. from N. Line

Ft. from S. Line

1120 Ft. from E. Line

Ft. from W. Line

SECTION PLAT

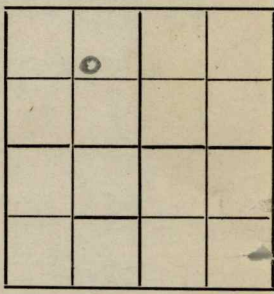

Location

Rig up

Drilling and Remarks:

Rig & Tools.
7/9 spud

RECORD

Cased in., ft.

Sand

Gas

Oil

Total Depth

PRODUCTION

1st 24 hrs. Nat.

1st 24 hrs. after shot

Gas Cu. Ft.

Dry Hole

Abandoned

Date

AUG 13 1922 191

M. A. BENEAR Scout

Form 26—1M—4-19—Mid-West

16

Map No. Kans Sec. 24 Twp. 23 R. 10

Well No. 1 Burkett

Nye Bair et al. Company

Contractor

COMPLETED


1120 Ft. from N. Line

Ft. from S. Line

1120 Ft. from E. Line

Ft. from W. Line

SECTION PLAT

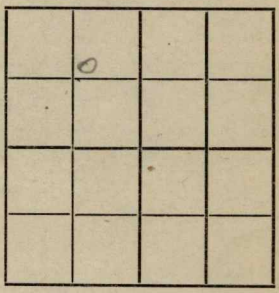

Location

Rig up

Drilling and Remarks:

Sand 2080-2097
Sand 2102-2133
producing from
second Sand
90 gts 260 lbs.

RECORD

Cased in., ft.

Sand

Gas

Oil

Total Depth

PRODUCTION

1st 24 hrs. Nat.

1st 24 hrs. after shot

Gas Cu. Ft.

Dry Hole

Abandoned

Date

OCT 21 1922

191

Scout