
Form 51 5M 7-22 9573

Map No. _____ Sec. 24 Twp. 23 R. 10

Well No. 3 Burkett Farm

White Eagle Company

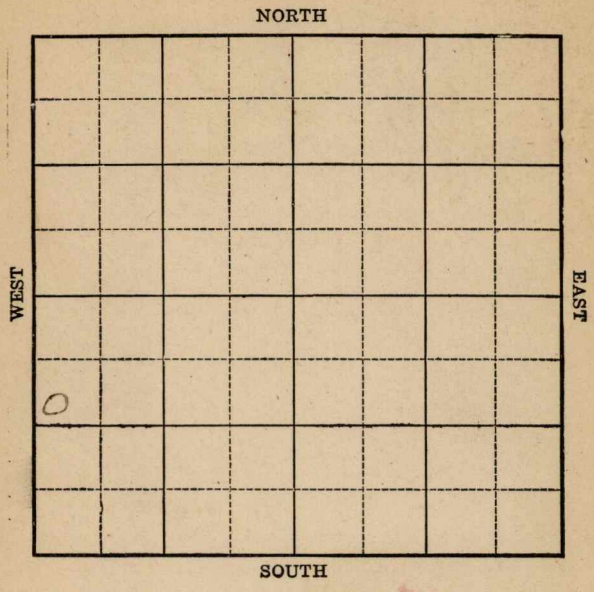

FIRST REPORT

Location _____

Drilling Remarks:

Rig up _____

Drilling Remarks:

RECORD

Cased _____ in. _____ ft.

Sand _____

Gas _____

Oil _____

Total Depth _____

PRODUCTION

1st 24 hrs Nat. _____

1st 24 hrs. after shot _____

Gas _____ cu. ft.

Dry Hole _____

Abandoned _____

Form 252A 5M 8-21 PALACE-TULSA 6835

Map No. Sec. 24 Twp. 23 R. 10

Well No. 3 Burkett Farm


White Eagle Company

990 Ft. from N. Line

Ft. from S. Line

Ft. from E. Line

330 Ft. from W. Line

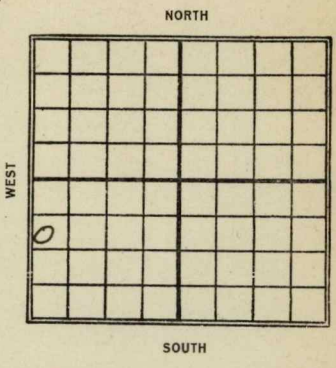

Date 1923	REPORT
1/6	Rgn. up.
3/22	Sand 2030-2100 - Shot 160 qts. 200 Bbls.

Form 26—1M—4-19—Mid-West

Map No. KANSAS Sec. 24 Twp. 23 R. 10

Well No. 3 Burkett

White Eagle Company

Contractor

FIRST REPORT


990 Ft. from N. Line

Ft. from S. Line

Ft. from E. Line

330 Ft. from W. Line

SECTION PLAT

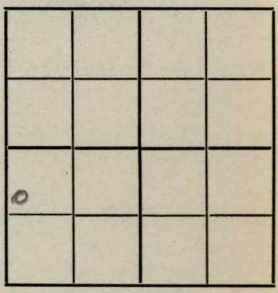

Location

Rig up

Drilling and Remarks:

Rig up

RECORD

Cased in., ft.

Sand

Gas

Oil

Total Depth

PRODUCTION

1st 24 hrs. Nat.

1st 24 hrs. after shot

Gas Cu. Ft.

Dry Hole

Abandoned

Date

JAN 6 1923

191

M. A. BENEAR

Scout

Form 26—1M—4-19—Mid-West

KANSAS

Map No. 6 Sec. 24 Twp. 23 R. 10

Well No. 3 Burkett

White Eagle Company

Contractor

COMPLETED


SECTION PLAT

990' Ft. from N. Line

Ft. from S. Line

Ft. from E. Line

330' Ft. from W. Line

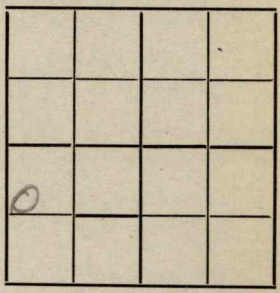

Location

Rig up

Drilling and Remarks:

sand {2030'
2100'

TD. 2102

shot 160 qts

200 #10,

RECORD

Cased in., ft.

Sand

Gas

Oil

Total Depth

PRODUCTION

1st 24 hrs. Nat.

1st 24 hrs. after shot

Gas Cu. Ft.

Dry Hole

Abandoned

Date

MAR 22 1923

191

M. A. BENEAR

Scout