

Map No. _____ Sec. 24 Twp. 23 R. 10
Well No. 25 Burkett Farm _____
Tidal Company _____

NORTH

WEST

EAST

SOUTH

Location _____

Drilling Remarks:

Rig up _____

Drilling Remarks:

RECORD

Cased _____ in. _____ ft.

Sand _____

Gas _____

Oil _____

Total Depth_____

PRODUCTION

1st 24 hrs Nat. _____

1st 24 hrs. after shot_____

Gas _____ cu. ft.

Dry Hole _____


Abandoned _____

Map No. _____ Sec. 24 Twp. 23 R. 10Well No. 5 Burkett Farm _____
Tidal Company _____990 Ft. from N. Line

_____ Ft. from S. Line

990 Ft. from E. Line

_____ Ft. from W. Line

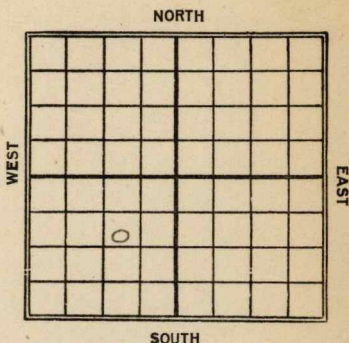

Date

REPORT

19238/8Sly 575'8/24J.S. 2028- Pay 2060-65
Pay 2098-2108- J.D. 2110
Shot 100 gts. 15 Bbl.

16 KANSAS Map No. _____ Sec. 24 Twp. 23 R. 10

Well No. 5 Burkett _____

Tidal _____ Company _____

_____ Contractor _____

FIRST REPORT SECTION PLAT

990 _____ Ft. from N. Line

_____ Ft. from S. Line

990 _____ Ft. from E. Line

_____ Ft. from W. Line

	0		

Location _____

Rig up _____

Drilling and Remarks:

Log 575

RECORD

Cased _____ in., _____ ft.

Sand _____

Gas _____

Oil _____

Total Depth _____

PRODUCTION

1st 24 hrs. Nat. _____

1st 24 hrs. after shot _____

Gas _____ Cu. Ft.

Dry Hole _____

Abandoned _____

Date

AUG 4 1923

M. A. BENEAR

192

Scout

Map No. KANSAS 16 Sec. 24 Twp. 23 R. 10

Well No. 5 Burkitt

Tidal Company

Contractor

COMPLETED

SECTION PLAT

990 Ft. from N. Line

_____ Ft. from S. Line

990 Ft. from E. Line

_____ Ft. from W. Line

Location _____

Rig up _____

Drilling and Remarks:

Top. 1. 2028
Pay 2060-35'
Pay 2098-2108'
210. 2110'
100 | 15

RECORD

Cased _____ in., _____ ft.

Sand _____

Gas _____

Oil _____

Total Depth _____

PRODUCTION

1st 24 hrs. Nat. _____

1st 24 hrs. after shot _____

Gas _____ Cu. Ft.

Dry Hole _____

Abandoned _____

Date

AUG 24 1925

M. A. BENEAR

192

Scout