

Sec. 9 Twp. 27 Range 4E


#1 Anderson

Kansas Geological Society

Cosden Oil + Gas

Skelly Scout Tickets

Map No. \_\_\_\_\_ Sec. 9 Twp. 37 R. 4  
 Well No. 1 Anderson Farm  
Leslie O'Brien Company

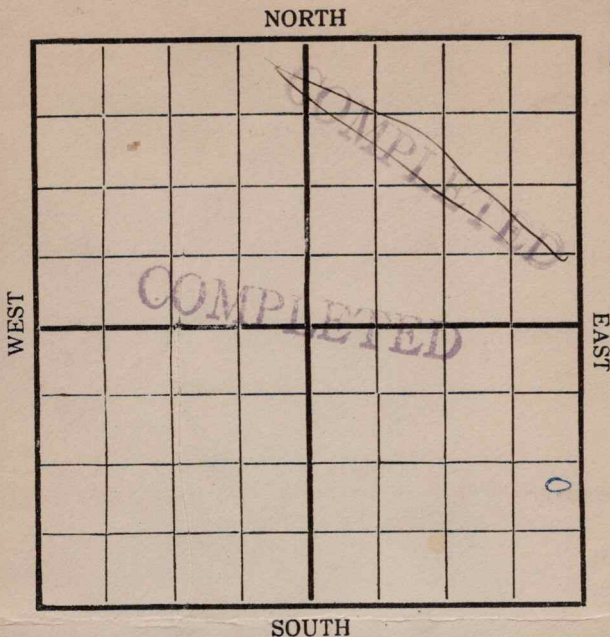

Location \_\_\_\_\_

Rig Up \_\_\_\_\_

Drilling Remarks:

Drilling Remarks:

7/10 1310 mudding gas  
10/2 - Top of sand  
10/10 - " "  
10/27 - In sand 26'  
12/15 = drilling deeper at 2057'  

RECORD


PRODUCTION

Cased \_\_\_\_\_ in \_\_\_\_\_ Ft.  
 Sand 1944-1986  
 Gas \_\_\_\_\_  
 Oil \_\_\_\_\_  
 Total Depth \_\_\_\_\_

1st 24 hrs. Nat. Est. 200  
 1st 24 hrs. after shot \_\_\_\_\_  
 Gas \_\_\_\_\_ Cu. Ft.  
 Dry Hole \_\_\_\_\_  
 Abandoned \_\_\_\_\_

Map No. \_\_\_\_\_ Sec. 9 Twp. 27 R. 4Well No. Anderson Farm \_\_\_\_\_Manufactures or Company \_\_\_\_\_NORTH Cosden Oil Co.

WEST

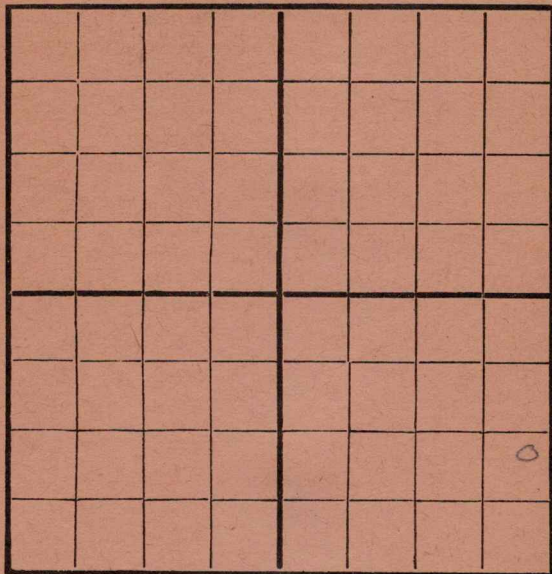

EAST

SOUTH

Location \_\_\_\_\_

Rig Up \_\_\_\_\_

Drilling and remarks \_\_\_\_\_

## RECORD

Cased \_\_\_\_\_ in. \_\_\_\_\_ Ft.

Sand \_\_\_\_\_

Gas \_\_\_\_\_

Oil \_\_\_\_\_

Total Depth \_\_\_\_\_

## PRODUCTION

1st 24 hrs. Nat. \_\_\_\_\_

1st 24 hrs. after shot \_\_\_\_\_

Gas \_\_\_\_\_ Cu. Ft.

Dry Hole \_\_\_\_\_

Abandoned \_\_\_\_\_

Date

6/21, 1916 Scott Scout

Map No. \_\_\_\_\_ Sec. 9 Twp. 22 R. 4


*Waring* \_\_\_\_\_ Company

NORTH of Cosden Oil!

WEST

EAST

SOUTH

NORTH

## SOUTH

## RECORD

Location \_\_\_\_\_

Rig Up-----

Drilling and remarks

Cased \_\_\_\_\_ in. \_\_\_\_\_ Ft.

Sand .....

Gas \_\_\_\_\_

Oil \_\_\_\_\_

Total Depth .....

## PRODUCTION

1st 24 hrs. Nat. -----

1st 24 hrs. after shot\_\_\_\_\_

Gas \_\_\_\_\_ Cu. Ft.

Dry Hole \_\_\_\_\_

Abandoned -----

Date \_\_\_\_\_

Scout

Map No. \_\_\_\_\_ Sec. 7 Twp. 22 R. 6

Well No. \_\_\_\_\_ Farm \_\_\_\_\_

Company \_\_\_\_\_


NORTH

OF COSBORO OIL &amp; GAS

1 KBBS

DML

WEST

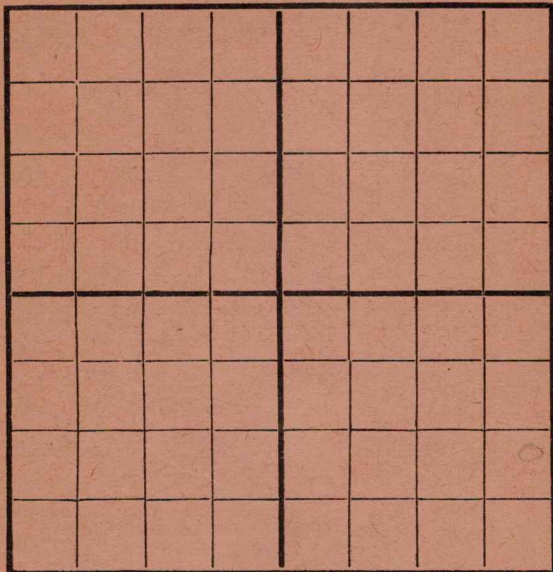

EAST

SOUTH

Location \_\_\_\_\_

Rig Up \_\_\_\_\_

Drilling and remarks

1010'

## RECORD

Cased \_\_\_\_\_ in. \_\_\_\_\_ Ft.

Sand \_\_\_\_\_

Gas \_\_\_\_\_

Oil \_\_\_\_\_

Total Depth \_\_\_\_\_

## PRODUCTION

1st 24 hrs. Nat. \_\_\_\_\_

1st 24 hrs. after shot \_\_\_\_\_

Gas \_\_\_\_\_ Cu. Ft.

Dry Hole \_\_\_\_\_

Abandoned \_\_\_\_\_

Date

\_\_\_\_\_, 1916 Scout

Map No. \_\_\_\_\_ Sec. 9 Twp. 22 R. 4Well No. 1 Farm \_\_\_\_\_Chadwick Company \_\_\_\_\_

NORTH

WEST

EAST

SOUTH

Location \_\_\_\_\_

Rig Up \_\_\_\_\_

Drilling and remarks

## RECORD

Cased \_\_\_\_\_ in. \_\_\_\_\_ Ft.

Sand \_\_\_\_\_

Gas \_\_\_\_\_

Oil \_\_\_\_\_

Total Depth \_\_\_\_\_

## PRODUCTION

1st 24 hrs. Nat. \_\_\_\_\_

1st 24 hrs. after shot \_\_\_\_\_

Gas \_\_\_\_\_ Cu. Ft.

Dry Hole \_\_\_\_\_

Abandoned \_\_\_\_\_

Date


7/15, 1916 Chadwick Scout

Map No. \_\_\_\_\_ Sec. 9 Twp. 27 R. 4  
 Well No. 1 Anderson Farm \_\_\_\_\_  
Anderson Oil Co. Company \_\_\_\_\_

NORTH

WEST

EAST

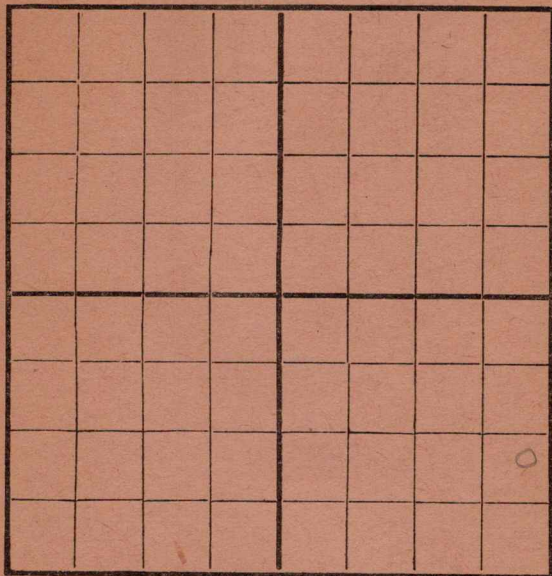

SOUTH

Location \_\_\_\_\_

Rig Up \_\_\_\_\_

Drilling and remarks

*1480 = about  
 4 1/2 million  
 gas*

## RECORD

Cased \_\_\_\_\_ in. \_\_\_\_\_ Ft.

Sand \_\_\_\_\_

Gas \_\_\_\_\_

Oil \_\_\_\_\_

Total Depth \_\_\_\_\_

## PRODUCTION

1st 24 hrs. Nat. \_\_\_\_\_

1st 24 hrs. after shot \_\_\_\_\_

Gas \_\_\_\_\_ Cu. Ft.

Dry Hole \_\_\_\_\_

Abandoned \_\_\_\_\_

Date


*7/15*, 1916 *McClary* Scout

Map No. \_\_\_\_\_ Sec. 9 Twp. 27 R. 4  
 Well No. 1 Anderson Farm \_\_\_\_\_  
Cooden Oil Company \_\_\_\_\_

NORTH

WEST

EAST

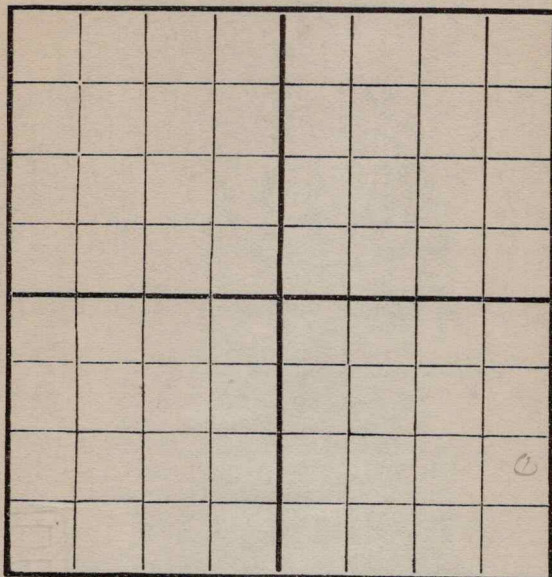

SOUTH

Location \_\_\_\_\_  
 Rig Up \_\_\_\_\_  
 Drilling and remarks \_\_\_\_\_

1570

## RECORD

Cased \_\_\_\_\_ in. \_\_\_\_\_ Ft.  
 Sand \_\_\_\_\_  
 Gas \_\_\_\_\_  
 Oil \_\_\_\_\_  
 Total Depth \_\_\_\_\_

## PRODUCTION

1st 24 hrs. Nat. \_\_\_\_\_  
 1st 24 hrs. after shot \_\_\_\_\_  
 Gas \_\_\_\_\_ Cu. Ft.  
 Dry Hole \_\_\_\_\_  
 Abandoned \_\_\_\_\_

Date


7/7, 1916 L. C. Dwyer Scout

Map No. \_\_\_\_\_ Sec. 9 Twp. 27 R. 4Well No. 10 Farm \_\_\_\_\_Company Cooper Oil Co.

NORTH

WEST

EAST

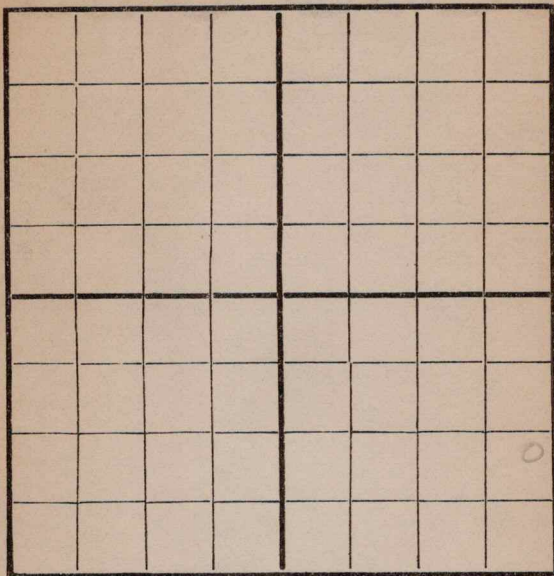

SOUTH

Location \_\_\_\_\_

Rig Up \_\_\_\_\_

Drilling and remarks

*Showing of  
oil at 1664*

## RECORD

Cased \_\_\_\_\_ in. \_\_\_\_\_ Ft.

Sand \_\_\_\_\_

Gas \_\_\_\_\_

Oil \_\_\_\_\_

Total Depth \_\_\_\_\_

## PRODUCTION

1st 24 hrs. Nat. \_\_\_\_\_

1st 24 hrs. after shot \_\_\_\_\_

Gas \_\_\_\_\_ Cu. Ft.

Dry Hole \_\_\_\_\_

Abandoned \_\_\_\_\_

Date

7/18, 1917 Cooper Oil Co. Scout

Map No. \_\_\_\_\_ Sec. 9 Twp. 27 R. 4Well No. 1 Farm \_\_\_\_\_

Company \_\_\_\_\_

NORTH

WEST

EAST

SOUTH

Location \_\_\_\_\_

Rig Up \_\_\_\_\_

Drilling and remarks

*about 35 bbl in*  
*shallow swirl*  
*Drilling 1890*

## RECORD

Cased \_\_\_\_\_ in. \_\_\_\_\_ Ft.

Sand \_\_\_\_\_

Gas \_\_\_\_\_

Oil \_\_\_\_\_

Total Depth \_\_\_\_\_

## PRODUCTION

1st 24 hrs. Nat. \_\_\_\_\_

1st 24 hrs. after shot \_\_\_\_\_

Gas \_\_\_\_\_ Cu. Ft.

Dry Hole \_\_\_\_\_


Abandoned \_\_\_\_\_

Date

8/1, 1916. Blair Scout

Map No. \_\_\_\_\_ Sec. 9 Twp. 27 R. 4  
 Well No. 1 Anderson Farm \_\_\_\_\_  
Anderson Company \_\_\_\_\_

NORTH

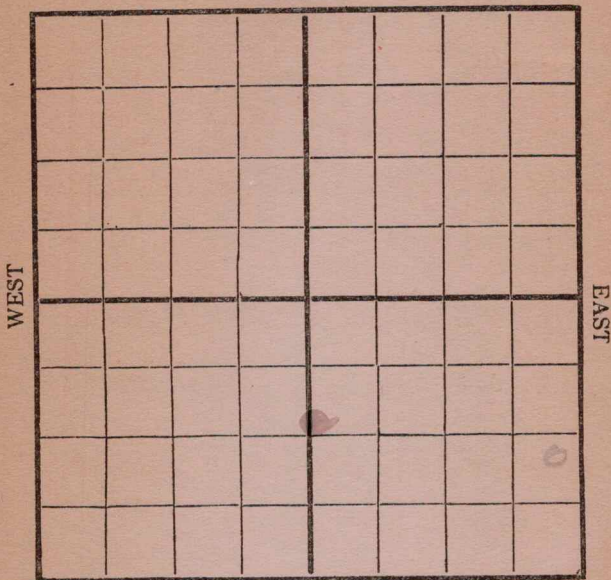

SOUTH

Location \_\_\_\_\_  
 Rig Up \_\_\_\_\_  
 Drilling and remarks \_\_\_\_\_

*Shut Down  
 Top sand*

RECORD

Cased \_\_\_\_\_ in. \_\_\_\_\_ Ft.  
 Sand \_\_\_\_\_  
 Gas \_\_\_\_\_  
 Oil \_\_\_\_\_  
 Total Depth \_\_\_\_\_

PRODUCTION

1st 24 hrs. Nat. \_\_\_\_\_  
 1st 24 hrs. after shot \_\_\_\_\_  
 Gas \_\_\_\_\_ Cu. Ft.  
 Dry Hole \_\_\_\_\_  
 Abandoned \_\_\_\_\_

Date


8/7, 1916 Scout

Map No. \_\_\_\_\_ Sec. 9 Twp. 27 R. 4  
 Well No. Canderson Farm \_\_\_\_\_  
Cosden Company \_\_\_\_\_

NORTH

WEST

EAST

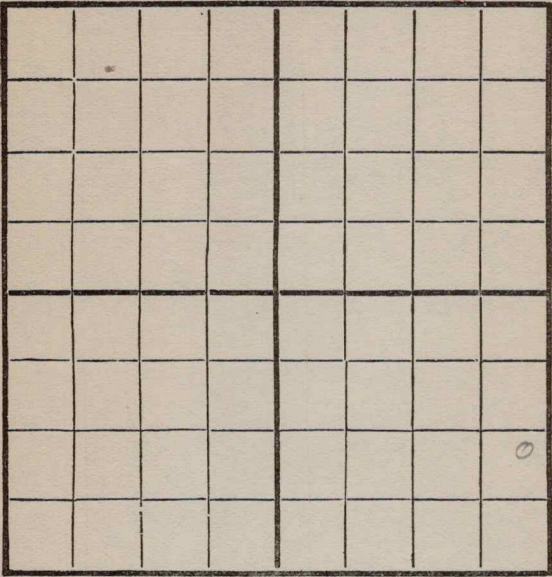

SOUTH

Location \_\_\_\_\_  
 Rig Up \_\_\_\_\_  
 Drilling and remarks \_\_\_\_\_

*One top of sand*

RECORD

Cased \_\_\_\_\_ in. \_\_\_\_\_ Ft.  
 Sand \_\_\_\_\_  
 Gas \_\_\_\_\_  
 Oil \_\_\_\_\_  
 Total Depth \_\_\_\_\_

PRODUCTION

1st 24 hrs. Nat. \_\_\_\_\_  
 First 24 h. s. after shot \_\_\_\_\_  
 Gas \_\_\_\_\_ Cu. Ft.  
 Dry Hole \_\_\_\_\_  
 Abandoned \_\_\_\_\_

Date 8, 1916 L. C. Huff Scout


AUG 30 1916

Map No. \_\_\_\_\_ Sec. 9 Twp. 27 R. 4Well No. 191 Anderson Farm \_\_\_\_\_Cosden Company \_\_\_\_\_

NORTH

WEST

EAST

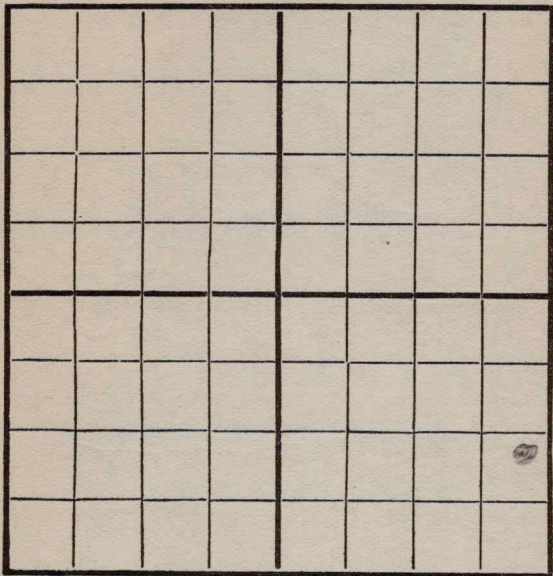

SOUTH

Location \_\_\_\_\_

Rig Up \_\_\_\_\_

Drilling and remarks

Out of sand

## RECORD

Cased \_\_\_\_\_ in. \_\_\_\_\_ Ft.

Sand 7 \_\_\_\_\_

Gas \_\_\_\_\_

Oil \_\_\_\_\_

Total Depth \_\_\_\_\_

## PRODUCTION

1st 24 hrs. Nat. \_\_\_\_\_

1st 24 hrs. after shot \_\_\_\_\_

Gas \_\_\_\_\_ Cu. Ft.

Dry Hole \_\_\_\_\_


Abandoned \_\_\_\_\_

Date

9/6, 1916Alley Scout

Map No. \_\_\_\_\_ Sec. 9 Twp. 27 R. 4  
 Well No. Anderson Farm \_\_\_\_\_  
Cosden Company \_\_\_\_\_

NORTH

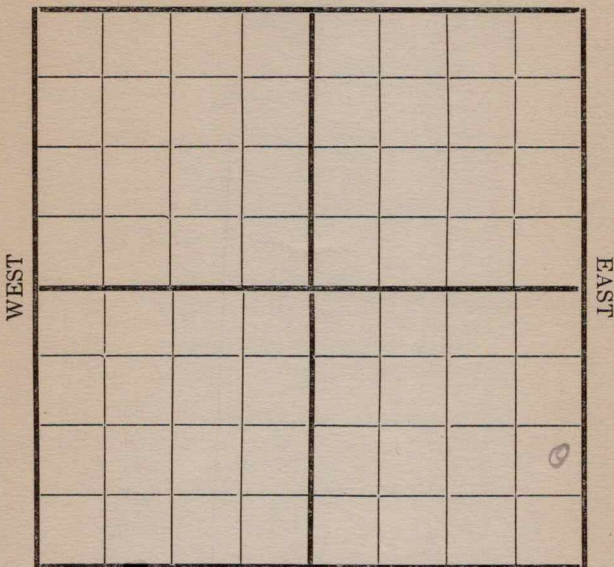

SOUTH

Location \_\_\_\_\_  
 Rig Up \_\_\_\_\_  
 Drilling and remarks \_\_\_\_\_

*me top  
 south*

RECORD

Cased \_\_\_\_\_ in. \_\_\_\_\_ Ft.  
 Sand 1949 \_\_\_\_\_  
 Gas \_\_\_\_\_  
 Oil \_\_\_\_\_  
 Total Depth \_\_\_\_\_

PRODUCTION


1st 24 hrs. Nat. \_\_\_\_\_  
 1st 24 hrs. after shot \_\_\_\_\_  
 Gas \_\_\_\_\_ Cu. Ft.  
 Dry Hole \_\_\_\_\_  
 Abandoned \_\_\_\_\_

Date

9/11, 1916 J.P. Anderson Scout

Map No. \_\_\_\_\_ Sec. 9 Twp. 22 R. 4  
Well No. 1 Anderson Farm \_\_\_\_\_  
Cooper Company \_\_\_\_\_

NORTH

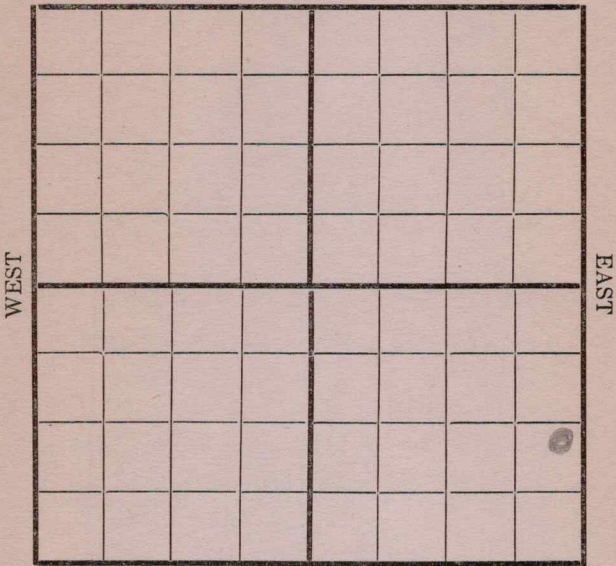

SOUTH

Location \_\_\_\_\_  
Rig Up \_\_\_\_\_  
Drilling and remarks \_\_\_\_\_

Deep sand

RECORD

Cased \_\_\_\_\_ in. \_\_\_\_\_ Ft.  
Sand 1944 \_\_\_\_\_  
Gas \_\_\_\_\_  
Oil \_\_\_\_\_  
Total Depth \_\_\_\_\_


PRODUCTION

1st 24 hrs. Nat. \_\_\_\_\_  
1st 24 hrs. after shot \_\_\_\_\_  
Gas \_\_\_\_\_ Cu. Ft.  
Dry Hole \_\_\_\_\_  
Abandoned \_\_\_\_\_

Date 9/19, 1916 S. C. Anderson Scout

Map No. \_\_\_\_\_ Sec. 7 Twp. 27 R. 4  
 Well No. 1944 Farm \_\_\_\_\_  
 \_\_\_\_\_ Company \_\_\_\_\_

NORTH

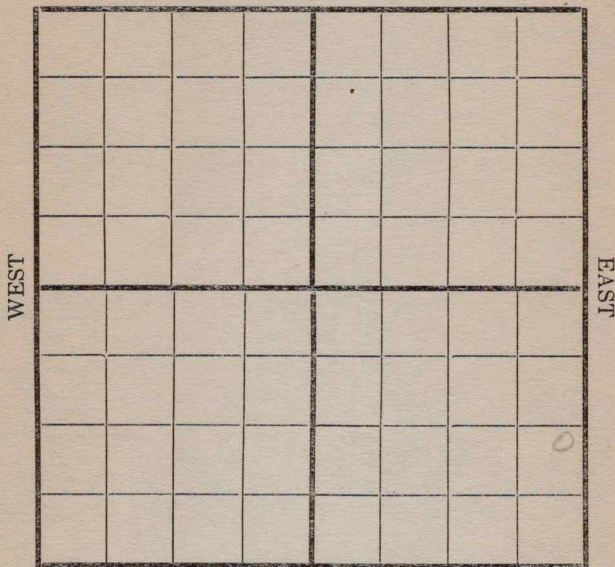

SOUTH

Location \_\_\_\_\_

Rig Up \_\_\_\_\_

Drilling and remarks

*Top sand*  
*1944*

RECORD

Cased \_\_\_\_\_ in. \_\_\_\_\_ Ft.

Sand \_\_\_\_\_

Gas \_\_\_\_\_

Oil \_\_\_\_\_

Total Depth \_\_\_\_\_

PRODUCTION

1st 24 hrs. Nat. \_\_\_\_\_

1st 24 hrs. after shot \_\_\_\_\_

Gas \_\_\_\_\_ Cu. Ft.

Dry Hole \_\_\_\_\_

Abandoned \_\_\_\_\_

Date


9/25 1916 Alma Dyer Scout

Map No. \_\_\_\_\_ Sec. 9 Twp. 27 R. 4Well No. 1 Anderson FarmAnderson Company

NORTH

WEST

EAST

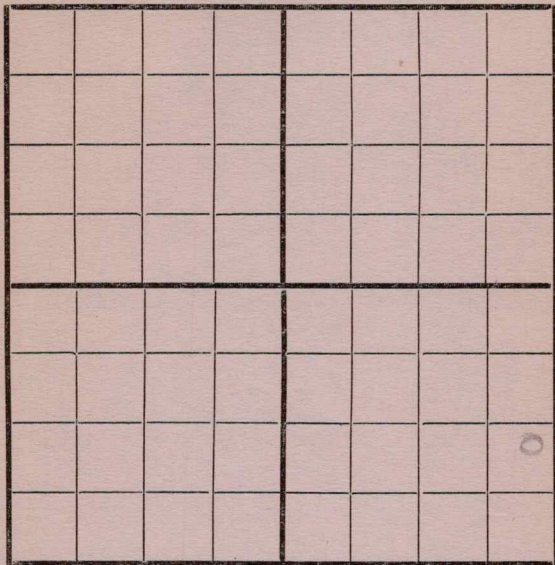

SOUTH

Location \_\_\_\_\_

Rig Up \_\_\_\_\_

Drilling and remarks

Top sand

## RECORD

Cased \_\_\_\_\_ in. \_\_\_\_\_ Ft.

Sand \_\_\_\_\_

Gas \_\_\_\_\_

Oil \_\_\_\_\_

Total Depth \_\_\_\_\_

## PRODUCTION

1st 24 hrs. Nat. \_\_\_\_\_

1st 24 hrs. after shot \_\_\_\_\_

Gas \_\_\_\_\_ Cu. Ft.

Dry Hole \_\_\_\_\_

Abandoned \_\_\_\_\_

Date


10/2, 191 6-22-11 Scout

Map No. \_\_\_\_\_ Sec. 9 Twp. 22 R. 4  
 Well No. 1 \_\_\_\_\_ Farm \_\_\_\_\_  
Co. Lee \_\_\_\_\_ Company \_\_\_\_\_

NORTH

WEST

EAST

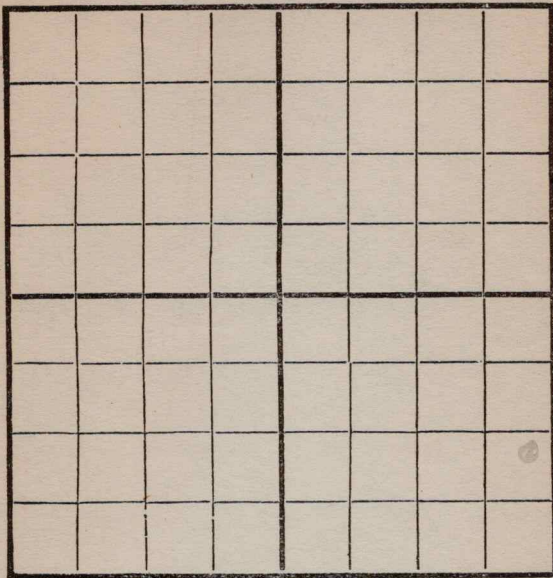

SOUTH

Location \_\_\_\_\_  
 Rig Up \_\_\_\_\_  
 Drilling and remarks \_\_\_\_\_

## RECORD

Cased \_\_\_\_\_ in. \_\_\_\_\_ Ft.  
 Sand \_\_\_\_\_  
 Gas \_\_\_\_\_  
 Oil \_\_\_\_\_  
 Total Depth \_\_\_\_\_

## PRODUCTION


1st 24 hrs. Nat. \_\_\_\_\_  
 First 24 hrs. after shot \_\_\_\_\_  
 Gas \_\_\_\_\_ Cu. Ft.  
 Dry Hole \_\_\_\_\_  
 Abandoned \_\_\_\_\_

Date

12/10, 1916 Co. Lee Scout

Map No. \_\_\_\_\_ Sec. 9 Twp. 27 R. 4  
 Well No. 1 Anderson Farm \_\_\_\_\_  
Cosden Company \_\_\_\_\_

NORTH

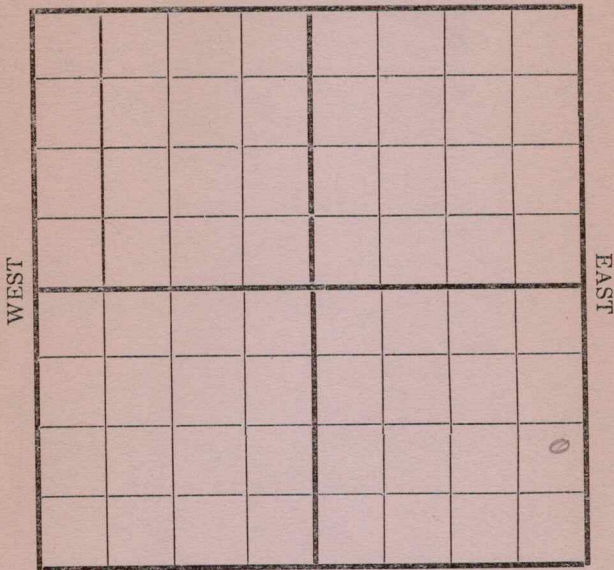

SOUTH

Location \_\_\_\_\_  
 Rig Up \_\_\_\_\_  
 Drilling and remarks \_\_\_\_\_

*In sand  
 26' and  
 1800 ft  
 fluid in  
 hole*

RECORD

Cased \_\_\_\_\_ in. \_\_\_\_\_ Ft.  
 Sand 1944  
 Gas \_\_\_\_\_  
 Oil \_\_\_\_\_  
 Total Depth \_\_\_\_\_

PRODUCTION

1st 24 hrs. Nat. \_\_\_\_\_  
 1st 24 hrs. after shot \_\_\_\_\_  
 Gas \_\_\_\_\_ Cu. Ft.  
 Dry Hole \_\_\_\_\_  
 Abandoned \_\_\_\_\_

Date

10/17, 1916 L. C. C. S. Scout

Map No. \_\_\_\_\_ Sec. 9 Twp. 22 R. 4  
 Well No. 1000 Farm \_\_\_\_\_  
 \_\_\_\_\_ Company

NORTH

WEST

EAST

COMPLETED

SOUTH

Location \_\_\_\_\_  
 Rig Up \_\_\_\_\_  
 Drilling and remarks \_\_\_\_\_

*Est at  
 about 200  
 R.R.*

RECORD

Cased \_\_\_\_\_ in. \_\_\_\_\_ Ft.  
 Sand 1944-1986  
 Gas \_\_\_\_\_  
 Oil \_\_\_\_\_  
 Total Depth \_\_\_\_\_

PRODUCTION

1st 24 hrs. Nat. \_\_\_\_\_  
 First 24 h.s. after shot \_\_\_\_\_  
 Gas \_\_\_\_\_ Cu. Ft.  
 Dry Hole \_\_\_\_\_  
 Abandoned \_\_\_\_\_

Date


10/23, 1916 Lee, J. J. Scout

Map No. \_\_\_\_\_ Sec. 9 Twp. 27 R. 4Well No. Anderson FarmCosden Company

NORTH

WEST

EAST

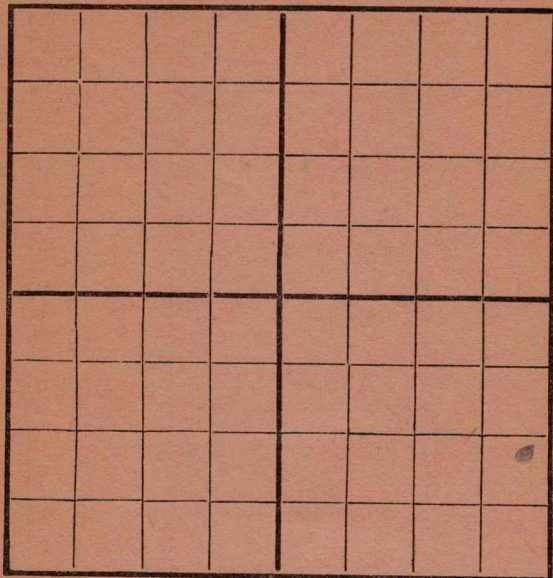

SOUTH

## RECORD

Location \_\_\_\_\_

Cased \_\_\_\_\_ in. \_\_\_\_\_ Ft.

Rig Up \_\_\_\_\_

Sand \_\_\_\_\_

Drilling and remarks

Gas \_\_\_\_\_

Oil \_\_\_\_\_

Total Depth \_\_\_\_\_

## PRODUCTION

1st 24 hrs. Nat. \_\_\_\_\_

1st 24 hrs. after shot \_\_\_\_\_

Gas \_\_\_\_\_ Cu. Ft.

Dry Hole \_\_\_\_\_

Abandoned \_\_\_\_\_

Date


12/11, 1916, Pandey Scout

Drilling  
Deeper  
Tools in hole  
at 2057'

Map No. \_\_\_\_\_ Sec. 9 Twp. 27 R. 4Well No. 1 Anderson Farm  
Cosden Company

NORTH

WEST

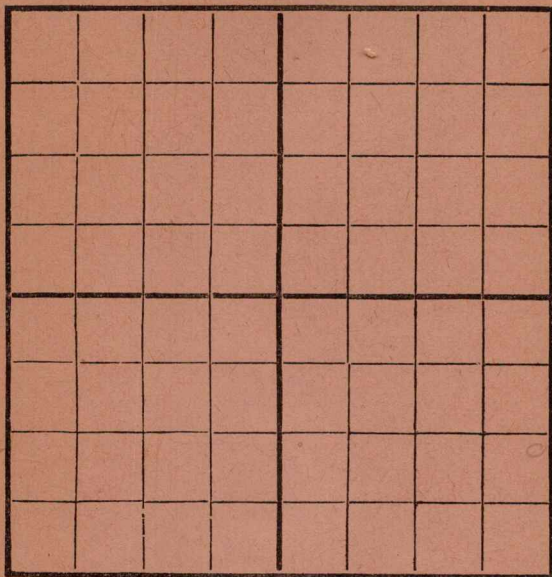

EAST

SOUTH

Location \_\_\_\_\_

Rig Up \_\_\_\_\_

Drilling and remarks

## RECORD

Cased \_\_\_\_\_ in. \_\_\_\_\_ Ft.

Sand \_\_\_\_\_

Gas \_\_\_\_\_

Oil \_\_\_\_\_

Total Depth \_\_\_\_\_

## PRODUCTION

1st 24 hrs. Nat. \_\_\_\_\_

1st 24 hrs. after shot \_\_\_\_\_

Gas \_\_\_\_\_ Cu. Ft.

Dry Hole \_\_\_\_\_

Abandoned \_\_\_\_\_


Date

12/18, 1916 Cosden Scout

Map No. \_\_\_\_\_ Sec. 9 Twp. 27 R. 4  
 Well No. 1 Anderson Farm \_\_\_\_\_  
Co. de Company \_\_\_\_\_

NORTH

WEST

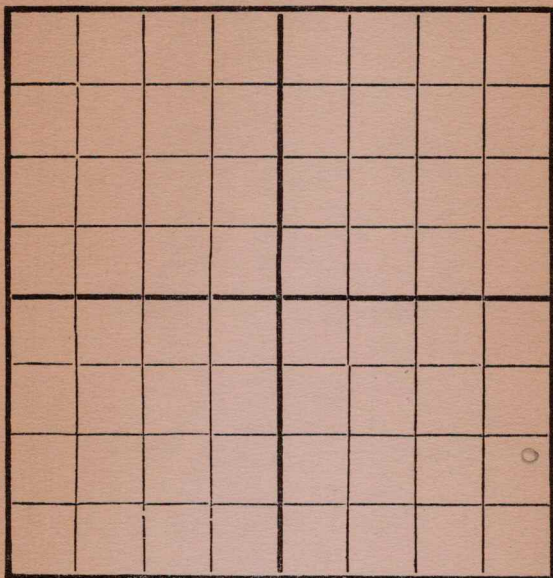

EAST

SOUTH

Location \_\_\_\_\_

Rig Up \_\_\_\_\_

Drilling and remarks

*Fishing*  
*2057'*

## RECORD

Cased \_\_\_\_\_ in. \_\_\_\_\_ Ft.

Sand \_\_\_\_\_

Gas \_\_\_\_\_

Oil \_\_\_\_\_

Total Depth \_\_\_\_\_

## PRODUCTION

1st 24 hrs. Nat. \_\_\_\_\_

First 24 hrs. after shot \_\_\_\_\_

Gas \_\_\_\_\_ Cu. Ft.

Dry Hole \_\_\_\_\_

Abandoned \_\_\_\_\_

Date


*12/27* 191 *6* *Co. de* Scout

Map No. \_\_\_\_\_ Sec. 9 Twp. 27 R. 4  
 Well No. Lamberson Farm \_\_\_\_\_  
Casbeer Company \_\_\_\_\_

NORTH

WEST

EAST

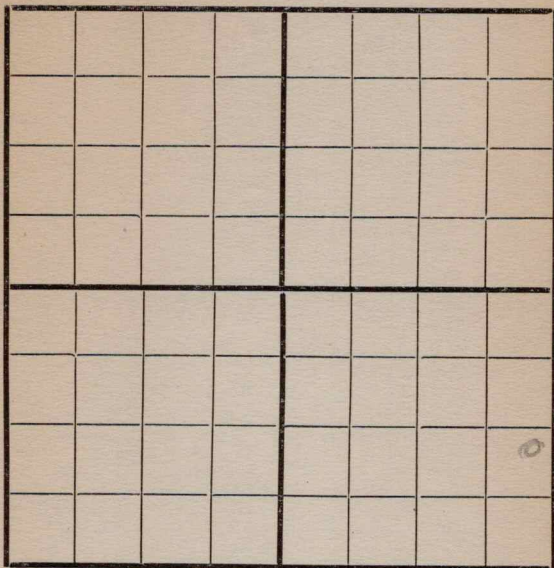

SOUTH

Location \_\_\_\_\_  
 Rig Up \_\_\_\_\_  
 Drilling and remarks \_\_\_\_\_

*Fishing at*  
*2057'*

RECORD

Cased \_\_\_\_\_ in. \_\_\_\_\_ Ft.  
 Sand \_\_\_\_\_  
 Gas \_\_\_\_\_  
 Oil \_\_\_\_\_  
 Total Depth \_\_\_\_\_

PRODUCTION

1st 24 hrs. Nat. \_\_\_\_\_  
 1st 24 hrs. after shot \_\_\_\_\_  
 Gas \_\_\_\_\_ Cu. Ft.  
 Dry Hole \_\_\_\_\_  
 Abandoned \_\_\_\_\_


Date

1/1, 1917 Casbeer Scov \_\_\_\_\_

Map No. \_\_\_\_\_ Sec. 9 Twp. 32 R. 4  
 Well No. 1 \_\_\_\_\_ Farm \_\_\_\_\_  
Coastal \_\_\_\_\_ Company \_\_\_\_\_

NORTH

WEST

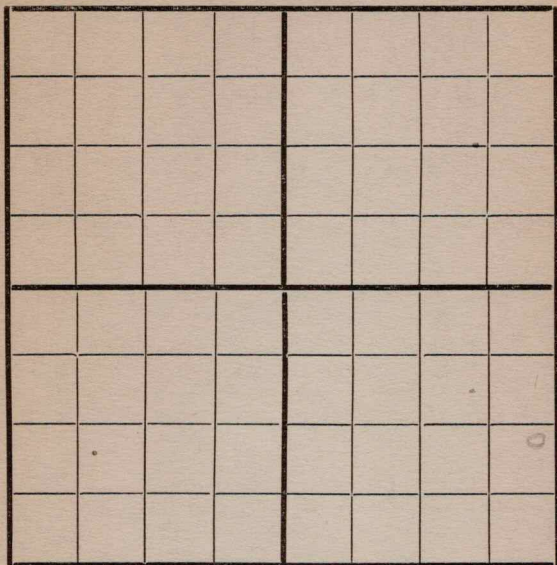

EAST

SOUTH

Location \_\_\_\_\_  
 Rig Up \_\_\_\_\_  
 Drilling and remarks \_\_\_\_\_

*Fishing at*  
*3057*

## RECORD

Cased \_\_\_\_\_ in. \_\_\_\_\_ Ft.  
 Sand \_\_\_\_\_  
 Gas \_\_\_\_\_  
 Oil \_\_\_\_\_  
 Total Depth \_\_\_\_\_

## PRODUCTION

1st 24 hrs. Nat. \_\_\_\_\_  
 1st 24 hrs. after shot \_\_\_\_\_  
 Gas \_\_\_\_\_ Cu. Ft.  
 Dry Hole \_\_\_\_\_  
 Abandoned \_\_\_\_\_

Date

1/8, 1917 Coastal Scout

Map No. \_\_\_\_\_ Sec. 9 Twp. 27 R. 4  
 \_\_\_\_\_ Company \_\_\_\_\_

NORTH

WEST

EAST

SOUTH

Location \_\_\_\_\_

Rig Up \_\_\_\_\_

Drilling and remarks

*One string  
 tools out  
 Have had on  
 search -  
 2057'*

## RECORD

Cased \_\_\_\_\_ in. \_\_\_\_\_ Ft.

Sand \_\_\_\_\_

Gas \_\_\_\_\_

Oil \_\_\_\_\_

Total Depth \_\_\_\_\_

## PRODUCTION

1st 24 hrs. Nat. \_\_\_\_\_

1st 24 hrs. after shot \_\_\_\_\_

Gas \_\_\_\_\_ Cu. Ft.

Dry Hole \_\_\_\_\_

Abandoned \_\_\_\_\_

Date

1/18, 1912 \_\_\_\_\_ Scout

Map No. \_\_\_\_\_ Sec. 9 Twp. 27 R. 4  
Well No. Anderson Farm \_\_\_\_\_  
Cushman Company \_\_\_\_\_

NORTH

WEST

EAST

SOUTH

Location\_\_\_\_\_

Rig Up ..... 222

Drilling and remarks

## RECORD

Cased \_\_\_\_\_ in. \_\_\_\_\_ Ft.

Sand.....

Gas \_\_\_\_\_

Oil\_\_\_\_\_

Total Depth.....

## PRODUCTION

1st 24 hrs. Nat. \_\_\_\_\_

1st 24 hrs. after shot-----

Gas \_\_\_\_\_ Cu. Ft.

Dry Hole-----


Abandoned\_ \_ \_ \_ \_

Date \_\_\_\_\_

1/25, 1917. *Cond. J. L.* Scout

Map No. \_\_\_\_\_ Sec. 9 Twp. 27 R. 4  
 Well No. 1 Anderson Farm \_\_\_\_\_  
Cosden Company \_\_\_\_\_

NORTH

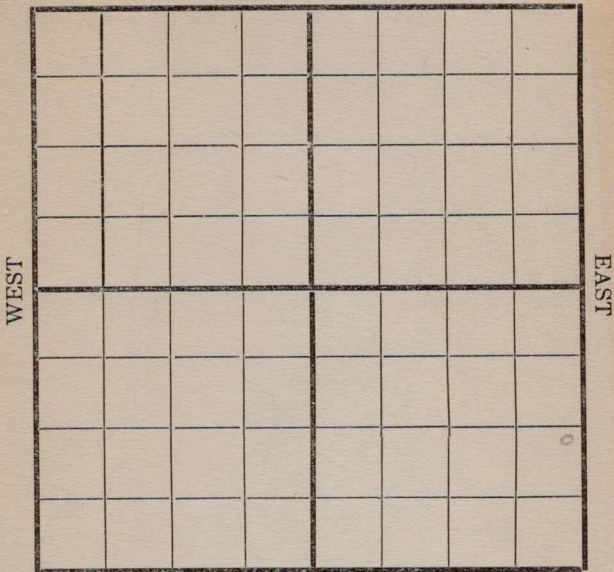

SOUTH

Location \_\_\_\_\_  
 Rig Up \_\_\_\_\_  
 Drilling and remarks \_\_\_\_\_

*Shut down*  
*2057*

RECORD

Cased \_\_\_\_\_ in. \_\_\_\_\_ Ft.  
 Sand \_\_\_\_\_  
 Gas \_\_\_\_\_  
 Oil \_\_\_\_\_  
 Total Depth \_\_\_\_\_

PRODUCTION

1st 24 hrs. Nat. \_\_\_\_\_  
 1st 24 hrs. after shot \_\_\_\_\_  
 Gas \_\_\_\_\_ Cu. Ft.  
 Dry Hole \_\_\_\_\_  
 Abandoned \_\_\_\_\_


Date

2/1, 1917 Cosden Scout



Map No. \_\_\_\_\_ Sec. 9 Twp. 27 R. 4  
 Well No. 1 Anderson Farm \_\_\_\_\_  
Cooper Company \_\_\_\_\_

NORTH

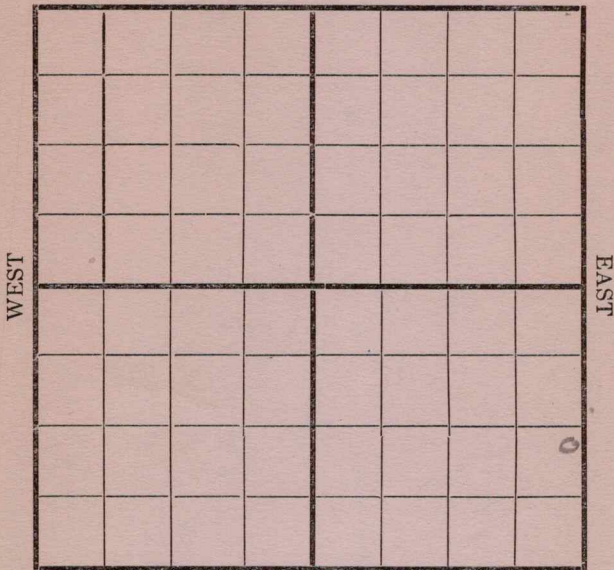


SOUTH

| RECORD                                 |                              |
|----------------------------------------|------------------------------|
| Location _____                         | Cased _____ in. _____ Ft.    |
| Rig Up _____                           | Sand _____                   |
| Drilling and remarks                   | Gas _____                    |
| <i>Drilling<br/>by tools<br/>2057'</i> | Oil _____                    |
|                                        | Total Depth _____            |
|                                        | PRODUCTION                   |
|                                        | 1st 24 hrs. Nat. _____       |
|                                        | 1st 24 hrs. after shot _____ |
|                                        | Gas _____ Cu. Ft.            |
|                                        | Dry Hole _____               |
|                                        | Abandoned _____              |

Date 2/16 1917 Conley Scout

Map No. \_\_\_\_\_ Sec. 9 Twp. 27 R. 4  
 Well No. 1 Anderson Farm \_\_\_\_\_  
Coaden Company \_\_\_\_\_

NORTH

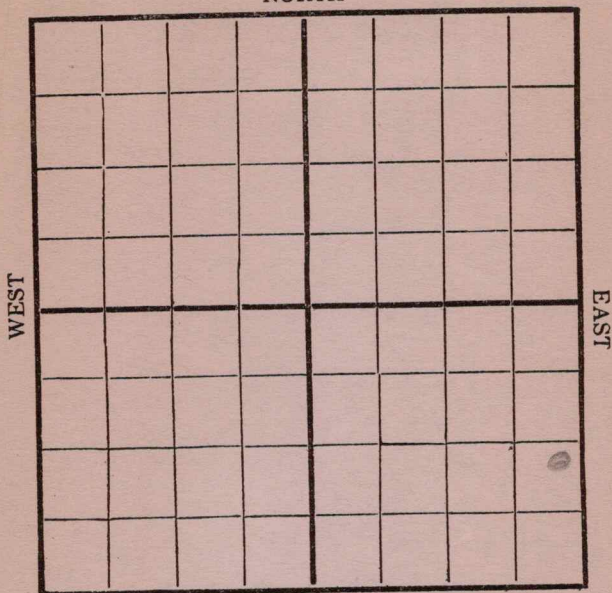

SOUTH

Location \_\_\_\_\_

Rig Up \_\_\_\_\_

Drilling and remarks

*Drilling by  
tools at  
2057'*

RECORD

Cased \_\_\_\_\_ in. \_\_\_\_\_ Ft.

Sand \_\_\_\_\_

Gas \_\_\_\_\_

Oil \_\_\_\_\_

Total Depth \_\_\_\_\_

PRODUCTION

1st 24 hrs. Nat. \_\_\_\_\_

1st 24 hrs. after shot \_\_\_\_\_

Gas \_\_\_\_\_ Cu. Ft.

Dry Hole \_\_\_\_\_

Abandoned \_\_\_\_\_


Date

3/19, 1917 Coaden Scout

Map No. K11 Sec. 9 Twp. 27 R. 4  
 Well No. Anderson Farm  
Cosden Company

NORTH

WEST

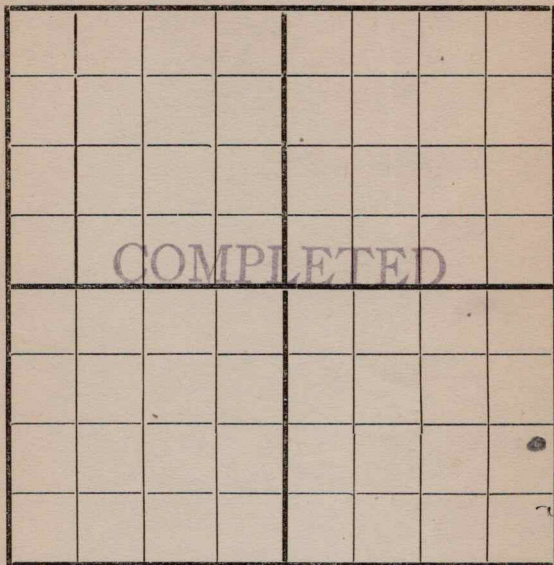

EAST

SOUTH

Location .....

Rig Up .....

Drilling and remarks

*Probably good  
for 40 Bbls*

## RECORD

Cased ..... in. .... Ft.

Sand 1944-2036

Gas .....

Oil .....

Total Depth .....

## PRODUCTION

1st 24 hrs. Nat. ....

1st 24 hrs. after shot .....

Gas ..... Cu. Ft.

Dry Hole .....

Abandoned .....

Date

3/2, 1917 Cordiff Scout