

Map No. _____ Sec. 24 Twp. 23 R. 10


Well No. 2 Burkett Farm
Nye Basil Etal Company

330 Ft. from N, Line

_____Ft. from S. Line

330 Ft. from E. Line

Ft. from W. Line

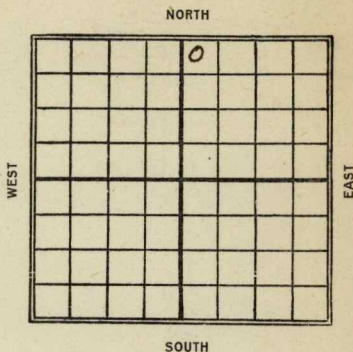

Date 1923

REPORT

1/6	R.O.M.
2/24	Land 2078-2108 - shot 80 gts. 75 Bbl.

Map No. **KANSAS** 16 24 Sec. Twp. 23 R. 10
 Well No. *2 Burkett East 80*
Nye Basil et al Company
 Contractor

FIRST REPORT

SECTION PLAT

330 Ft. from N. Line

Ft. from S. Line

330 Ft. from E. Line

Ft. from W. Line

		0	

Location

Rig up

Drilling and Remarks:

R.O.G.

RECORD

Cased in., ft.

Sand

Gas

Oil

Total Depth

PRODUCTION

1st 24 hrs. Nat.

1st 24 hrs. after shot

Gas Cu. Ft.

Dry Hole

Abandoned

Date

JAN 6 1923

M. A. BENEAR

191 Scout

Map No. **KANSAS** ¹⁶ Sec. **24** Twp. **23** R. **10**

Well No. **2 East 80 Burkett**

McC, Basil et al Company

Contractor

COMPLETED SECTION PLAT

-----Ft. from N. Line

-----Ft. from S. Line

-----Ft. from E. Line

-----Ft. from W. Line

		9	

Location -----

Rig up -----

Drilling and Remarks:

80 ft shot

RECORD

Cased ----- in., ----- ft.

Sand -----

Gas -----

Oil **2078-2108**

Total Depth -----

PRODUCTION

1st 24 hrs. Nat. -----

1st 24 hrs. after shot **73**

Gas ----- Cu. Ft.

Dry Hole -----

Abandoned -----

Date

FEB 24 1923

M. A. BENEAR