

Map No. _____ Sec. 24 Twp. 23 R. 10
Well No. 6 Burkett Farm _____
White Eagle Company _____

NORTH

WEST

EAST

SOUTH

Location _____

Drilling Remarks:

Rig up _____

Drilling Remarks:

RECORD

Cased _____ in. _____ ft.

Sand _____

Gas _____

Oil _____

Total Depth _____

PRODUCTION

1st 24 hrs Nat. _____

1st 24 hrs. after shot_____

Gas _____ cu. ft.

Dry Hole_____

Abandoned _____

Map No. _____ Sec. 24 Twp. 23 R. 10

Well No. 6 Burkett Farm _____
White Eagle Company _____


NORTH

330 Ft. from N. Line

_____ Ft. from S. Line

_____ Ft. from E. Line

330 Ft. from W. Line

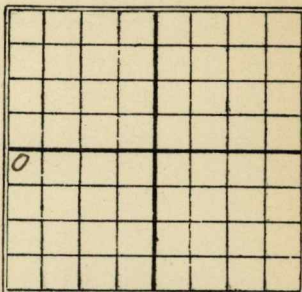

WEST

EAST

SOUTH

Date 1923

REPORT

3/2 Rig
4/20 Sand 2054-2109-Shot
160 gts. 125 Bbls.

Map No. **KANSAS** ¹⁶ Sec. ²⁴ Twp. ²³ R. ¹⁰Well No. ⁶ *Burkett**White Eagle* Company

Contractor

FIRST REPORT

330 Ft. from N. Line

Ft. from S. Line

Ft. from E. Line

330 Ft. from W. Line

SECTION PLAT

o			

Location

Rig up *✓✓*

Drilling and Remarks:

RECORD

Cased _____ in., _____ ft.

Sand _____

Gas _____

Oil _____

Total Depth _____

PRODUCTION

1st 24 hrs. Nat. _____

1st 24 hrs. after shot _____

Gas _____ Cu. Ft.

Dry Hole _____

Abandoned _____

Date

MAR 2 1923

M. A. BENEAR

191

Scout

Map No. ¹⁶~~KANSAS~~ Sec. ²⁴ Twp. ²³ R. ¹⁰Well No. ⁶ *Burkett*
White Eagle Company

Contractor

COMPLETED

SECTION PLAT

³³⁰ Ft. from N. Line

Ft. from S. Line

Ft. from E. Line

³³⁰ Ft. from W. Line

0			

Location

Rig up

Drilling and Remarks:

sand 2054-2109
shot 160 ft
125 bbls

RECORD

Cased _____ in., _____ ft.

Sand _____

Gas _____

Oil _____

Total Depth _____

PRODUCTION

1st 24 hrs. Nat. _____

1st 24 hrs. after shot _____

Gas _____ Cu. Ft.

Dry Hole _____

Abandoned _____

Date

APR 20 1923

191

M. A. BENEAR

Scout