

Map No. 1 Sec. 25 Twp. 23 R. 10

Well No. 1 Haslett Farm

Daniel Company

NORTH

WEST

EAST

SOUTH

Location _____

Drilling Remarks:

Rig up _____

Drilling Remarks:

RECORD

Cased _____ in. _____ ft.

Sand _____

Gas _____

Oil _____

Total Depth_____

PRODUCTION

1st 24 hrs Nat. _____

1st 24 hrs. after shot_____

Gas _____ cu. ft.

Dry Hole_____

Abandoned _____

No. _____ Sec. 25 Twp. 23 R. 10

Well No. 1 Hazlett Farm


Davis Company

200 Ft. from N, Line

_____Ft. from S. Line

Ft. from E. Line

200 Ft. from W. Line

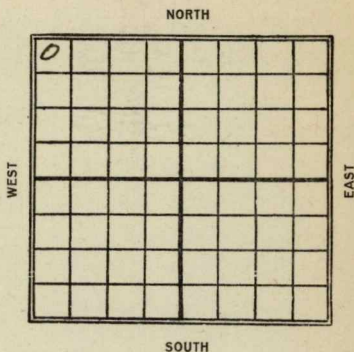

Date _____

REPORT

1923

1/6	Spud.
-----	-------

2/6	D.Y. 4-2325
-----	-------------

Map No. ¹⁶ **KANSAS** Sec. ²⁵ Twp. ²³ R. ¹⁰
Well No. ¹ *Haylett*
Lewis Company

Contractor

FIRST REPORT

SECTION PLAT

200 Ft. from N. Line

Ft. from S. Line

Ft. from E. Line

200 Ft. from W. Line

0			

Location

Rig up

Drilling and Remarks:

spud

RECORD

Cased _____ in., _____ ft.

Sand _____

Gas _____

Oil _____

Total Depth _____

PRODUCTION

1st 24 hrs. Nat. _____

1st 24 hrs. after shot _____

Gas _____ Cu. Ft.

Dry Hole _____

Abandoned _____

Date

JAN 6 1923

M. A. BENEAR

191

Scout

Map No. **KANSAS** Sec. *25* Twp. *23* R. *10*Well No. *1 - Haylett**L Davis et al* Company

Contractor

ABANDONED SECTION PLAT

200 Ft. from N. Line

Ft. from S. Line

Ft. from E. Line

200 Ft. from W. Line

0			

Location

Rig up

Drilling and Remarks:

Show oil 2950.
Top M.L. 2165'
Dry and
Abandoned
2325'

RECORD

Cased in., ft.

Sand

Gas

Oil

Total Depth

PRODUCTION

1st 24 hrs. Nat.

1st 24 hrs. after shot

Gas Cu. Ft.

Dry Hole

Abandoned

Date

FEB 6 1923

M. A. BENEAR

Scout