Sec. 26 Twp. 23 Range 10E

#4 Allen

Kansas Geological Society

Connell, etal.

Skelly Scout Tickets

Form 252A 8M-11-20 PALACE-TULSA 4617

Map No. Sec. 26 Twp. 23 R. 10

Well No. 4 Allen Farm


Connell Val Company

720 ~~#20~~ Ft. from N. Line

Ft. from S. Line

Ft. from E. Line

200 Ft. from W. Line

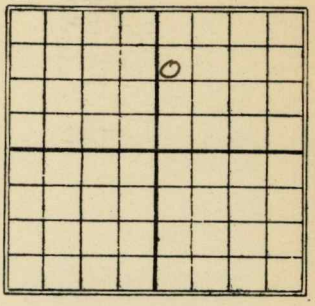

Date 1923	REPORT
3/2	Rig.
5/19	Sand 2210-90 - Pay 2240-90 - Shot 80 qts. 25 Bbls. T.D. 2295

Form 26—1M—4-19—Mid-West

Map No. KANSAS 16 Sec. 26 Twp. 23 R. 16

Well No. 4 Allen

Carmell etal Company

Contractor

FIRST REPORT


1120 Ft. from N. Line

Ft. from S. Line

Ft. from E. Line

200 Ft. from W. Line

SECTION PLAT

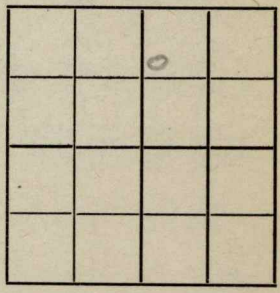

Location

Rig up

Drilling and Remarks:

RECORD

Cased in., ft.

Sand

Gas

Oil

Total Depth

PRODUCTION

1st 24 hrs. Nat.

1st 24 hrs. after shot

Gas Cu. Ft.

Dry Hole

Abandoned

Date MAR 2 1923

191

M. A. BENEAR Scout

Form 26—1M—4-19—Mid-West

Map No. KANSAS Sec. 26 Twp. 23 R. 10


Well No. 4 A Allen

Connell et al Company

Contractor

Was reported 1120 from N.

SECTION PLAT

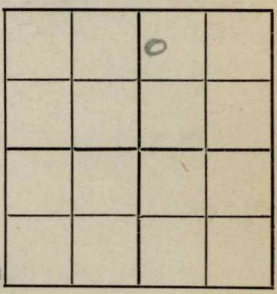

720 Ft. from N. Line

Ft. from S. Line

Ft. from E. Line

200 Ft. from W. Line

COMPLETED

Location

Rig up

Drilling and Remarks:

Sand 2210-90
Pay 2240-90
T.D 2295
Shot 80/25 bbls

RECORD

Cased in., ft.

Sand

Gas

Oil

Total Depth

PRODUCTION

1st 24 hrs. Nat.

1st 24 hrs. after shot

Gas Cu. Ft.

Dry Hole

Abandoned

Date

MAY 19 1923

191

M. A. BENEAR

Scout