Greenwood KANSAS

26 23S 10E

SECTION TOWNSHIP RANGE

WELL NO. #1 Mason

COMPANY Augusta Oil Co.

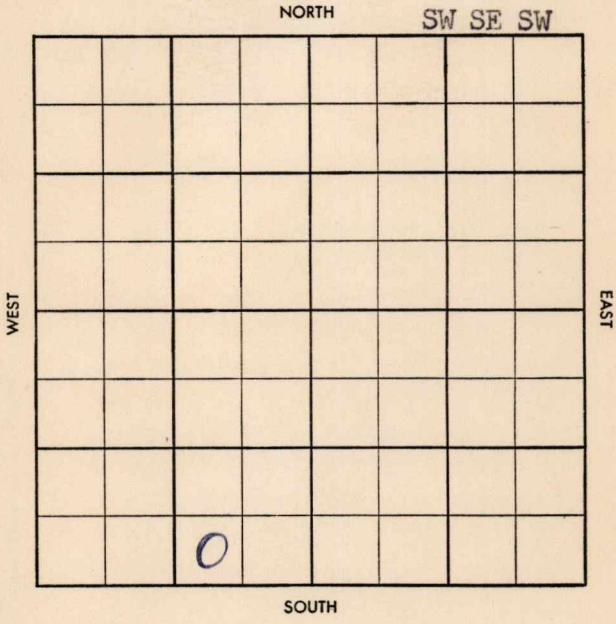

FORM 504-3 SUNRAY

S-513-A

CO. Greenwood ELEV.

SEC. 26 TWP. 23 RGE. 10E FIRST REPORT

COMPANY Augusta Oil Co. NO. 1

NOV 13 '57

FARM Mason

LOC. SW SE SW

GEOL.

CONTR. Co. Tools

POOL Burkett

SPUD 11/5/57

8" @ 159, KC 1550 Drlg. 1600.

CO. LSE. NO. SEC. TWP. RGE.

S-513-A

CO. Greenwood ELEV.

SEC. 26 TWP. 23 RGE. 10E

COMPANY Augusta Oil Co. NO. 1

ABANDONED
NOV 20 '57

FARM Mason

LOC. SW SE SW

GEOL.

CONTR. Co. Tools

POOL Burkett

SPUD 11/5/57

8" @ 159. KC 1550 Drlg
1600. NOV 20 '57

Bart 2105

TD 2169

D & A

CO.
LSE.
NO.
SEC.
TWP.
RGE.