
Form 51 5M 7-22 9573

Map No. _____ Sec. 23 Twp. 23 R. 10

Well No. 1 Scott Farm

Mid-Kansas Company

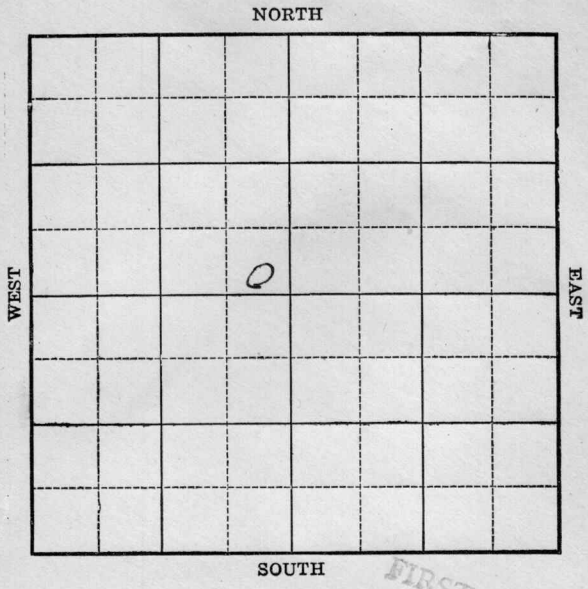

FIRST REPORT

Location _____

Drilling Remarks:

Rig up _____

Drilling Remarks:

RECORD

Cased _____ in. _____ ft.

Sand _____

Gas _____

Oil _____

Total Depth _____

PRODUCTION

1st 24 hrs Nat. _____

1st 24 hrs. after shot _____

Gas _____ cu. ft.

Dry Hole _____

Abandoned _____

Form 252A 5M 8-21 PALACE-TULSA 6835

Map No. _____ Sec. 23 Twp. 23 R. 10

Well No. 1 Scott Farm


Mid-Kansas Company

_____ Ft. from N. Line

250 Ft. from S. Line

250 Ft. from E. Line

_____ Ft. from W. Line

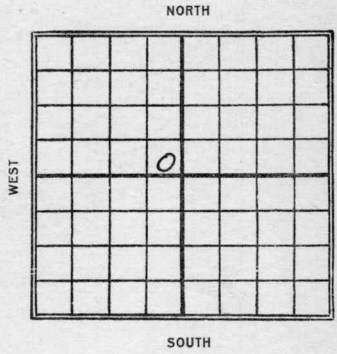

Date 1923	REPORT
1/6	Rig
3/22	Top sand 2067 - T.D. 2093 Water 2104-17 - Shot 40 qts. 50 Bbls. P.B. to 2104'

Form 26—1M—4-19—Mid-West

Map No. KANSAS Sec. 16 Twp. 23 R. 10


Well No. 1 Scott

Mid-Kansas Company

Contractor

FIRST REPORT

SECTION PLAT

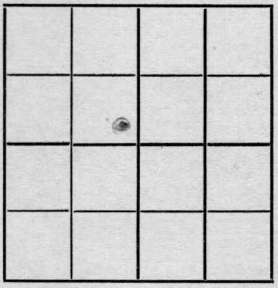

250 Ft. from N. Line

250 Ft. from S. Line

Ft. from E. Line

Ft. from W. Line

Location

Rig up 1/6

Drilling and Remarks:

RECORD

Cased in., ft.

Sand

Gas

Oil

Total Depth

PRODUCTION

1st 24 hrs. Nat.

1st 24 hrs. after shot

Gas Cu. Ft.

Dry Hole

Abandoned

Date

JAN 6 1923

191

M. A. BENEAR

Scout

Form 26—1M—4-19—Mid-West

KANSAS

Map No. _____ Sec. 33 Twp. 23 R. 10


Well No. 1 Scott

Mid-Kansas Company

_____ Contractor

COMPLETED

SECTION PLAT

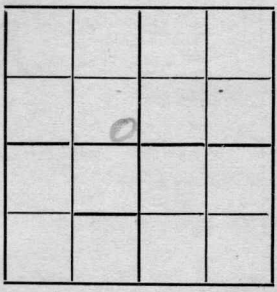

_____ Ft. from N. Line

250' Ft. from S. Line

250' Ft. from E. Line

_____ Ft. from W. Line

Location _____

Rig up _____

Drilling and Remarks:

Top L. 2067
T.D. 2093
Water 2109-17
P.B. 2109
40 qts 50 Hls

RECORD

Cased _____ in., _____ ft.

Sand _____

Gas _____

Oil _____

Total Depth _____

PRODUCTION

1st 24 hrs. Nat. _____

1st 24 hrs. after shot _____

Gas _____ Cu. Ft.

Dry Hole _____

Abandoned _____

Date

MAR 22 1923

_____ 191____.

M. A. BENEAR

_____ Scout