

Section 30 Township 28S Range 1EWell No. #1 Agnes SladeCompany Laura Jane

NORTH

WEST

EAST

		0					

SOUTH

Sedgwick

KANSAS

SEC.	TWP.	R.
30	28 S	1 E

WELL NO.

1 Agnes Slade

FARM

COMPANY

Laura Jane

CONTRACTOR

Co. Tools

Gladys

990

Ft. from N. Line


Ft. from S. Line

990

Ft. from E. Line

Ft. from W. Line

SW NE NW

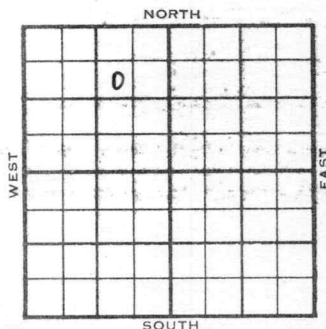

1954

ELEVATION

1274'

REPORT

12/8

Location

1955

2/16

Spud 12-10-54 - Oil Well

TD 3135'

8-5/8" @ 162'

Miss. 3127'

TD 3135'


5" @ 3129', 1000A

P/4 boph

P/165 bo

Comp. 107 bopd

COMPLETED

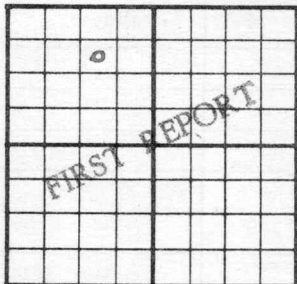County Sedgwick State KansasSec. 30 (Blk. 28S) (Sur. 1E) Map No.Operator Laura JaneWell No. 1 Farm Agnes SladeElev. Location SW NE NW990 Ft. From N Line990 Ft. From E Line NW Quarter1st. Report DEC 8 1954

Completion


Remarks

Spudding Date

Drlg. Data GladysLoc.

FABEN GILSTRAP

County Sedgwick State Kansas
 Sec. 30 (Blk. 28 (Sur. 1E Map No.
 (Twp.) (Rge.)
 Operator Laura Jane
 Well No. 1 Farm Agnes Ruby Slade
 Elev. 1274 Location SW NE NW

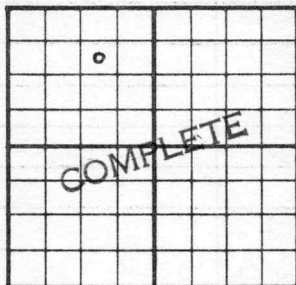

990 Ft. From N Line NW
990 Ft. From E Line Quarter
 1st. Report
 Completion FEB 1 6 1955
 Remarks Gladys Pool
Co. tools
 Spudding Date 12-10-54

Drlg. Data Oil well TD 3135
8 5/8" @ 162 Miss. 3127 TD 3135
5" @ 3129 1000 A P/ 4 boph P/ 165 bo
Comp. 107 bopd

FABEN GILSTRAP