

Map No. 116 Sec. 27 Twp. 23 R. 10

Well No. 1 B - Thrall Farm

No. 1 B - Thro
Mission

all # 32

NORTH

WEST

EAST

SOUTH

Location _____

Drilling Remarks:

Rig Up_____

Drilling Remarks:

RECORD

Cased _____ in. _____ ft.

Sand _____

Gas _____

Oil _____

Total Depth_____

PRODUCTION

1st 24 hrs. Nat. _____

1st 24 hrs. after shot_____

Gas _____ cu. ft.

Dry Hole _____

Abandoned _____

Map No. K Sec. 27 Twp. 23 R. 10

Well No. 1 B Thrall Farm


Mission Company

330 Ft. from N. Line

_____ Ft. from S. Line

330 Ft. from E. Line

_____ Ft. from W. Line

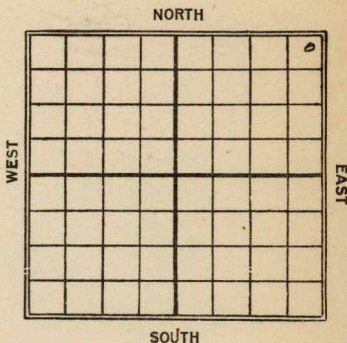

Date	REPORT
11/24	Spud.
1924	
2/19	Sand 2262-2342-
	160 gals/110 Bbls. 34 7397

Map No. **KANSAS** ¹⁶ Sec. 27 Twp. 23 R. 10
 Well No. 1B-T Hall
Mission Company

Contractor

SECTION PLAT

330 **FIRST REPORT**
 Ft. from N. Line

_____ Ft. from S. Line

330 Ft. from E. Line

_____ Ft. from W. Line

			0

Location _____

Rig up _____

Drilling and Remarks:

spud

RECORD

Cased _____ in., _____ ft.

Sand _____

Gas _____

Oil _____

Total Depth _____

PRODUCTION

1st 24 hrs. Nat. _____

1st 24 hrs. after shot _____

Gas _____ Cu. Ft.

Dry Hole _____

Abandoned _____

Date

NOV 24 1923

192

M. A. BENEAR

Scout

Map No. **KANSAS** ¹⁶ Sec. **27** Twp. **23** R. **10**Well No. **(1-B) Thrall****Mission Oil** Company

Contractor

COMPLETED

SECTION PLAT

330 Ft. from N. Line

Ft. from S. Line

330 Ft. from E. Line

Ft. from W. Line

			0

Location

Rig up

Drilling and Remarks:

sand 2262-2342**T.D. 2347'****160/110 lbf**

RECORD

Cased _____ in., _____ ft.

Sand _____

Gas _____

Oil _____

Total Depth _____

PRODUCTION

1st 24 hrs. Nat. _____

1st 24 hrs. after shot _____

Gas _____ Cu. Ft.

Dry Hole _____

Abandoned _____

Date

FEB 10 1924**M. A. BENEAR**

192

Scout