


Sedgwick County, Kansas

Section 30- Township 28S Range 1EWell No. #4 Agnes Ruby Slate (Slide)Company Laura Jane

NORTH

WEST

EAST

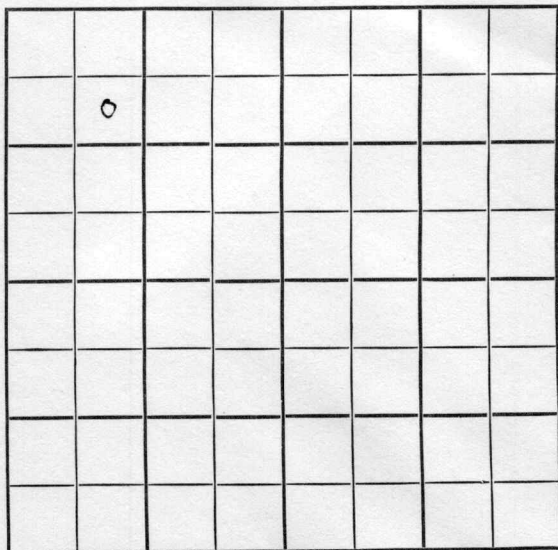

SOUTH

Sedgwick

KANSAS

SEC.	TWP.	R.
30	28	1E

WELL NO.

#4 Agnes Ruby Slade

FARM

COMPANY

Laura Jane

CONTRACTOR

Co. Tools

Gladys


Ft. from N. Line

Ft. from S. Line

Ft. from E. Line

Ft. from W. Line

SE NW NW

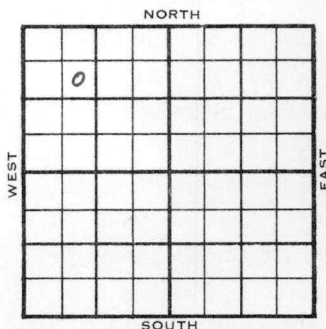

1955

ELEVATION

1276

REPORT

8/31

Comm 8-26-55

8" @ 164/170

Drlg 1480

9/28

Comm 8-26-55

8" @ 164 w/170

KC 2628

Dolo 3147

TD 3178

5 1/2" @ 3147/100 Co to 3178

F/8 boph 2000 A S/10 boph Comp 100
bopd

COMPLETED

County Sedgwick Elev. _____
 Sec. 30 Twp. 28 Rge. 1E
 Company Laura Jane
 Farm Name Agnes Ruby Slade No. 4

TOPS	DEPTH	LOG	DATUM
Anh.			
Tp.			
H.			
Tr.			
Dg.			
B.L.			
L.			
K.C.			
B.K.C.			
Ce.			
C.			
M.			
M.			
K.			
Mz.			
Me.			
V.			
S.			
S.			
A			
R.			
Pc.			
G.			
T.D.			

Loc. in Sec. _____

SENW NW

Geol. _____

Contr. _____

Co. tools

Pool _____

Gladys

FIRST REPORT

AUG 31 '55

Lse. _____

No. _____

Date Comm. 8-26-55

8" @ 164/170 drlg. 1480

County Sedgwick Elev. 1276
 Sec. 30 Twp. 28 Rge. 1E
 Company Laura Jane
 Farm Name Agnes Ruby Slade No. 4

TOPS	DEPTH	LOG	DATUM
Anh.			
Tp.			
H.			
Tr.			
Dg.			
BL.			
L.			
K.C.	<u>2628</u>		<u>1352</u>
B.K.C.			
Ce.			
C.			
M.			
M.	<u>Dolo</u>	<u>3147</u>	<u>1871</u>
K.			
Mz.			
Mq.			
V.			
S.			
S.			
A			
R.			
Pe.			
G.			
T.D.	<u>3178</u>		

Loc. in Sec. _____

SE NW NW

Geol. _____

Contr. _____

Co. tools _____

Pool _____

GladysDate Comm. 8-26-55 SEP 28 19558" @ 164/170 5 1/2" @ 3147/100 CO to3178 F/ 8 boph 2000' A S/ 10 boph

Comp. 100 bopd