

Map No. Kane Sec. 27 Twp. 23 R. 10

Well No. 30 Thrall Farm

Roth-Favroh & Mission Oil Company

NORTH

WEST

EAST

D

SOUTH

Location

Drilling Remarks

Rig Up_____

Drilling Remarks

RECORD

Cased_____in. _____ft.

Sand

Gas

Oil

Total Depth _____

PRODUCTION

1st 24 hrs. Nat.

1st 24 hrs. after shot _____

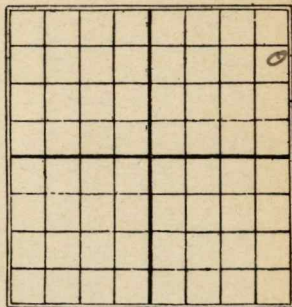
Gas _____ cu. ft.

Dry Hole

Abandoned

Map No. 3B KANSAS Sec. 27 Twp. 23 R. 10Well No. 2B Thrall FarmRoth Fawcett Mission Company

NORTH

792' Ft. from N. Line

Ft. from S. Line

264' Ft. from E. Line

Ft. from W. Line

1925

Date

REPORT

10/8 Rip10/22 400' @ 250'10/29 1000'11/27 Sand 2305-45
70 gts 20 Bbls

Sherwood Co

K 16
 Map No. KANSAS Sec. 27 Twp. 23 R. 10
 Well No. 3 B. 2nd

Roth-Faurot & Mission Company

Contractor

FIRST REPORTS

SECTION PLAT

792 Ft. from N. Line

_____ Ft. from S. Line

264 Ft. from E. Line

_____ Ft. from W. Line

Location _____

Rig up ☒

Drilling and Remarks:

RECORD

Cased _____ in., _____ ft.

Sand _____

Gas _____

Oil _____

Total Depth _____

PRODUCTION

1st 24 hrs. Nat. _____

1st 24 hrs. after shot _____

Gas _____ Cu. Ft.

Dry Hole _____

Abandoned _____

Date

OCT 8 1925

192

CHAS. L. SHERWOOD

Scout

K16 Map No. **KANSAS** Sec. **27** Twp. **23** R. **10**

Well No. **3 B** **Shall**
Roth - Lura & Mission Company

Contractor

COMPLETED

SECTION PLAT

792 Ft. from N. Line

_____ Ft. from S. Line

264 Ft. from E. Line

_____ Ft. from W. Line

			o

Location _____

Rig up _____

Drilling and Remarks:

Pay 2305-39'

707 20 bks

RECORD

Cased _____ in., _____ ft.

Sand **2305-2345**

Gas _____

Oil _____

Total Depth **2345'**

PRODUCTION

1st 24 hrs. Nat. _____

1st 24 hrs. after shot _____

Gas _____ Cu. Ft.

Dry Hole _____

Abandoned _____

Date

NOV 27 1925

CHAS. L. SHERWOOD

192

Scout