

Sedgwick


KANSAS

SECTION 30 TOWNSHIP 28 RANGE 1 E

WELL NO. #18 Tyson

COMPANY Beardmore

NORTH

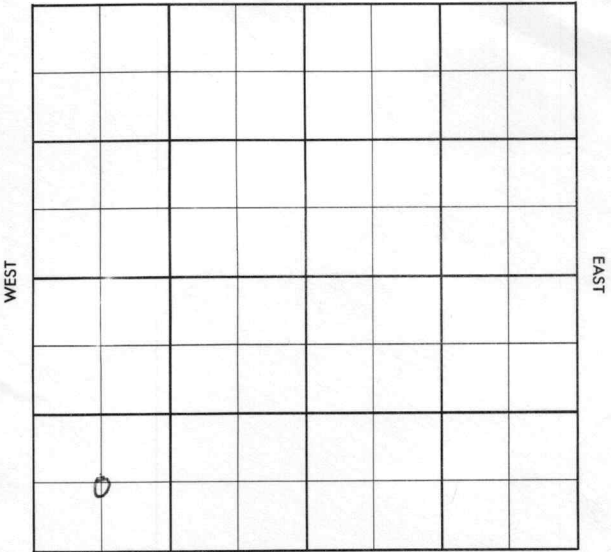

SOUTH

Sedgwick

KANSAS

SEC.	TWP.	R.
30	28	1E

WELL NO.

#18 Tyson

FARM

COMPANY

Beardmore

CONTRACTOR

Co. Tools

Gladys

Ft. from N. Line

556


Ft. from S. Line

Ft. from E. Line

758

Ft. from W. Line

C SW SW

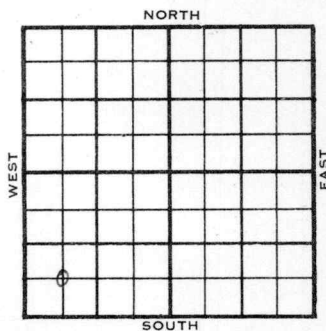

1956

ELEVATION

REPORT

1-18

Comm. 1-15-56
8" @ 152/120

County Sedgwick Elev. _____
 Sec. 30 Twp. 28 Rge. 1E
 Company Beardmore
 Farm Name Tyson No. 18

TOPS	DEPTH	LOG	DATUM	Loc. in Sec.	Lse.
Anh.				C SW SW	
Tp.				556' SL	
H.				758' WL	
Tr.					
Dg.					
Bl.					
L.				Geol.	
K.C.				Contr.	
B.K.C.				Co. tools	
Ce.					
C.				Pool	
M.				Gladys	
M.					
K.					
Mz.					
Mq.					
V.					
S.					
S.					
A.					
R.					
Pf.					
G.					
T.D.					

Date Comm. 1-15-56
8" @ 152/120

FIRST REPORT

JAN 18 1956

Co.

Lse.

No.

Sec.

T.

R.

County **Sedgwick** Elev. _____
 Sec. **30** Twp. **28** Rgn. **1E**
 Company **Beardmore**
 Farm Name **Tyson** No. **18**

TOPS	DEPTH	LOG	DATUM	Loc. in Sec.
Ant.				C SW SW
Tr.				556' SL
H.	<i>Vertical</i>			758' WL
Tr.				
Dg.				
Bl.				
L.				Geol. _____
K.C.				Contr. _____
BEC.				Co. tools
Ce.				Pool
C.				Gladys
M.	<i>Li</i>	<i>3152</i>		
M.	<i>Dale</i>	<i>3127</i>		
K.				
Me.				
Mo.				
V.				
S.				
S.				
A.				
R.				
Pe.				
G.				
KB	<i>?</i>	<i>3252</i>		

COMPLETE

Date Comm. **1-15-56**

FEB 29 1956

8" • 152/120

JAN 25 '56

2323 FEB 1 '56

5 1/2 3233

FEB 8 '56

5 1/2 3333 / FEB 15 '56

CO FEB 22 '56

CO 3252

17A

17 Boph no/wtr

FEB 29 '56

Ph P 190 Boph no/wtr