

Map No. _____ Sec. 28 Twp. 23 R. 10
Well No. 29 Brall Farm _____
Mission Company _____

NORTH

WEST

EAST

SOUTH

Location _____

Drilling Remarks:

Rig up _____

Drilling Remarks:

RECORD

Cased _____ in. _____ ft.

Sand _____

Gas _____

Oil _____

Total Depth_____

PRODUCTION

1st 24 hrs Nat. _____

1st 24 hrs. after shot_____

Gas _____ cu. ft.

Dry Hole_____

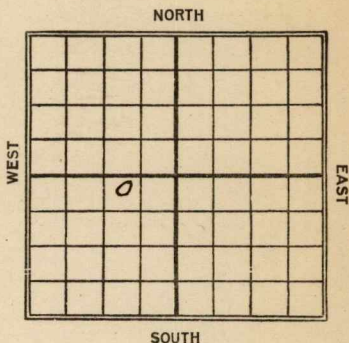
Abandoned _____

Map No. _____ Sec. 28 Twp. 23 R. 10Well No. 29 Thrall Farm _____
Mission Company _____264 Ft. from N. Line

_____ Ft. from S. Line

760 Ft. from E. Line

_____ Ft. from W. Line

Date
1923

REPORT

5/19Rig6/23Sand 2397-2450-
shot 120 gts. 50 Bbs.
ID. 2450

Map No. **KANSAS** 16 Sec 28 Twp. 23 R. 10
 Well No. 29 T. Hall
Mission Company

Contractor

FIRST REPORT**SECTION PLAT**264 Ft. from N. Line

Ft. from S. Line

760 Ft. from E. Line1820 Ft. from W. Line

	o		

Location

Rig up ☒

Drilling and Remarks:

RECORD

Cased _____ in., _____ ft.

Sand _____

Gas _____

Oil _____

Total Depth _____

PRODUCTION

1st 24 hrs. Nat. _____

1st 24 hrs. after shot _____

Gas _____ Cu. Ft.

Dry Hole _____

Abandoned _____

Date

MAY 19 1923**M. A. BENEAR**

192

Scout

Map No. **KANSAS** Sec. **28** Twp. **23** R. **10**

Well No. **29 thru**

Mission Oil Company

Contractor

COMPLETED SECTION PLAT

264

_____ Ft. from N. Line

_____ Ft. from S. Line

760

_____ Ft. from E. Line

_____ Ft. from W. Line

	0		

Location _____

Rig up _____

Drilling and Remarks:

Sand { 2397
2450
7.10 2455
120/50

RECORD

Cased _____ in., _____ ft.

Sand _____

Gas _____

Oil _____

Total Depth _____

PRODUCTION

1st 24 hrs. Nat. _____

1st 24 hrs. after shot _____

Gas _____ Cu. Ft.

Dry Hole _____

Abandoned _____

Date

JUN 23 1923

M. A. BENEAR

_____ 192_____

_____ Scout