


Map No.        Sec. 28 Twp. 23 R. 10 ✓  
Well No. 41 - Thrall Farm  
Roth & Mission Company

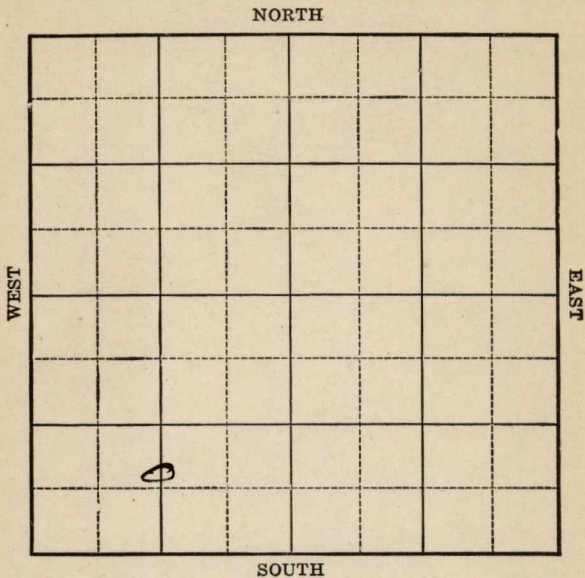

Location \_\_\_\_\_

Drilling Remarks:

Rig Up \_\_\_\_\_

Drilling Remarks:

RECORD

Cased \_\_\_\_\_ in. \_\_\_\_\_ ft.  
Sand \_\_\_\_\_  
Gas \_\_\_\_\_  
Oil \_\_\_\_\_  
Total Depth \_\_\_\_\_

PRODUCTION


1st 24 hrs. Nat. \_\_\_\_\_  
1st 24 hrs. after shot \_\_\_\_\_  
Gas \_\_\_\_\_ cu. ft.  
Dry Hole \_\_\_\_\_  
Abandoned \_\_\_\_\_

Map No. K Sec. 28 Twp. 23 R. 10Well No. 41 Shrall FarmBooth & Mission Company

Ft. from N. Line

760 Ft. from S. Line

Ft. from E. Line

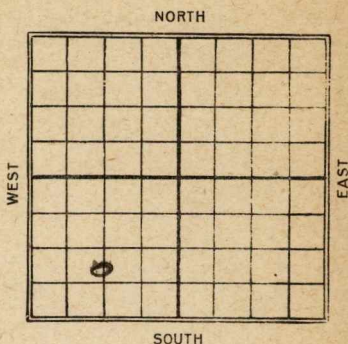1320 Ft. from W. Line

## REPORT

Date

19244/21Rug up4/24Rug7/9Top 2281-Pay 2301-40720 2345-100/50 Bld

**KANSAS** 16  
Map No. \_\_\_\_\_ Sec. 28 Twp. 23 R. 10  
Well No. #41 Thrall  
Rath & Mission Company

\_\_\_\_\_  
Contractor

FIRST REPORT

SECTION PLAT

\_\_\_\_\_  
Ft. from N. Line  
760 Ft. from S. Line  
\_\_\_\_\_  
Ft. from E. Line  
1320 Ft. from W. Line

|  |  |  |  |
|--|--|--|--|
|  |  |  |  |
|  |  |  |  |
|  |  |  |  |
|  |  |  |  |
|  |  |  |  |

Location \_\_\_\_\_  
Rig up ✓✓  
Drilling and Remarks:

**RECORD**  
Cased \_\_\_\_\_ in., \_\_\_\_\_ ft.  
Sand \_\_\_\_\_  
Gas \_\_\_\_\_  
Oil \_\_\_\_\_  
Total Depth \_\_\_\_\_

**PRODUCTION**  
1st 24 hrs. Nat. \_\_\_\_\_  
1st 24 hrs. after shot \_\_\_\_\_  
Gas \_\_\_\_\_ Cu. Ft.  
Dry Hole \_\_\_\_\_  
Abandoned \_\_\_\_\_

Date  
APR 21 1924

M. A. BENEAB

Map No. **KANSAS** Sec. *28* Twp. *23* R. *10*

Well No. *41 Thrall*  
*Rath & Mission* Company

Contractor

COMPLETED

SECTION PLAT

\_\_\_\_\_ Ft. from N. Line

*760* \_\_\_\_\_ Ft. from S. Line

\_\_\_\_\_ Ft. from E. Line

*1320* \_\_\_\_\_ Ft. from W. Line

|   |  |  |  |
|---|--|--|--|
|   |  |  |  |
|   |  |  |  |
|   |  |  |  |
|   |  |  |  |
| 0 |  |  |  |

Location \_\_\_\_\_

Rig up \_\_\_\_\_

Drilling and Remarks:

*Laps. 2281*  
*Pay 2301-40*  
*J.D. 2345*  
*100/50*

RECORD

Cased \_\_\_\_\_ in., \_\_\_\_\_ ft.

Sand \_\_\_\_\_

Gas \_\_\_\_\_

Oil \_\_\_\_\_

Total Depth \_\_\_\_\_

PRODUCTION

1st 24 hrs. Nat. \_\_\_\_\_

1st 24 hrs. after shot \_\_\_\_\_

Gas \_\_\_\_\_ Cu. Ft.

Dry Hole \_\_\_\_\_

Abandoned \_\_\_\_\_

Date

*JUL 9 1924*

192

Scout