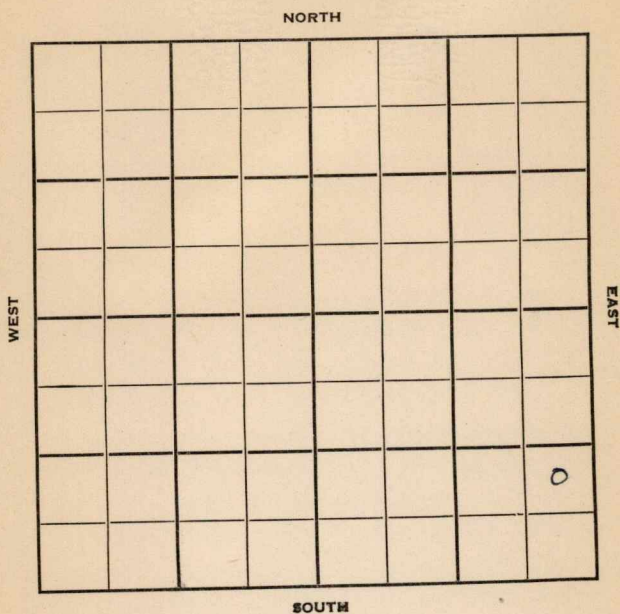


Section 34 Township 25 Range 10-EWell No. #1 NaukCompany Southwestern Prod.

Sec. 34 Twp. 25 R. 10-E

Well No. #1 Nauk Farm

Southwestern Prod Company

Contractor

Miscellaneous

Ft. from N. Line

990


Ft. from S. Line

330

Ft. from E. Line

Ft. from W. Line

Approx NE SE SE

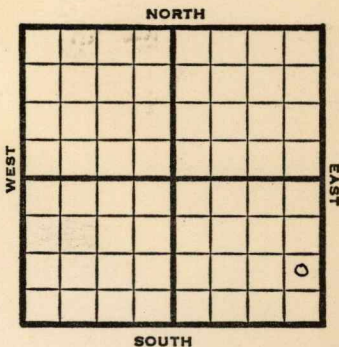

1950

?

REPORT

9/6

Cellar & Pits

11/8

8" @ 85

Miss 1969

6" @ 1971

TD 1975

1 bo

DD 1980 HFW

DD 2030

TD 2030

D&A

ABANDONED

County Greenwood State KansasSec. 34 (Blk.) 25 (Sur.) 10E Map No.Operator Southwestern Prod.Well No. 1 Farm NaukElev. _____ Location Approx. NE SE SE

990 Ft. From S Line SE330 Ft. From E Line Quarter1st. Report SEP 6 1950


Completion _____

Remarks _____

Spudding Date _____

Drilg. Data MiscellaneousCellar & pits

J. E. TYRA

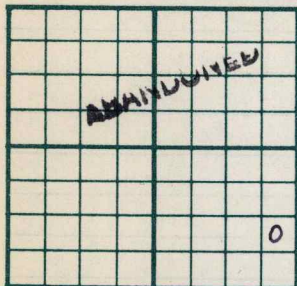County Greenwood State KansasSec. 34 (Blk.) 25 (Sur.) 10E Map No.Operator Southwestern Prod.Well No. 1 Farm NaukElev. Location Approx. NE SE SE990 Ft. From S Line SE330 Ft. From E Line Quarter1st. ReportCompletion NOV 8 1950RemarksSpudding Date 9-11-50Drlg. Data D & A TD 20308" @ 85 Miss. 1969 6" @ 1971TD 1975 1 bo DD 1980 HFW DD 2030D & A

J. E. TYRA