


Map No. _____ Sec. 35 Twp. 25 R. 10

Well No. 1 Clark Farm _____

Rogers Et al Company _____

NORTH

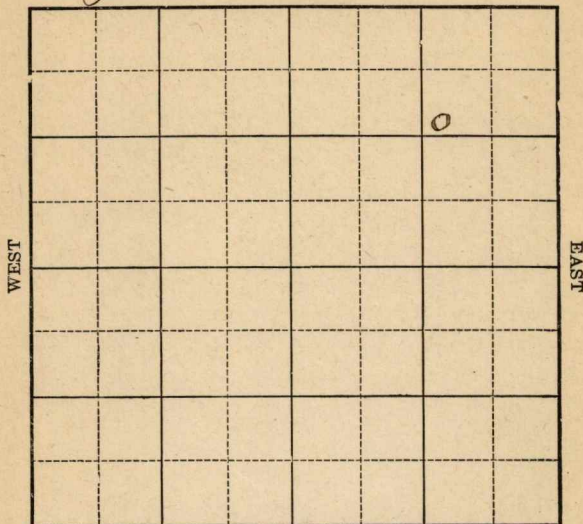

SOUTH

Location _____

Drilling Remarks:

Rig Up _____

Drilling Remarks:

RECORD

Cased _____ in. _____ ft.

Sand _____

Gas _____

Oil _____

Total Depth _____

PRODUCTION

1st 24 hrs. Nat. _____

1st 24 hrs. after shot _____

Gas _____ cu. ft.

Dry Hole _____

Abandoned _____

Map No. _____ Sec. 35 Twp. 25 R. 10

Well No. # 1 Clark Farm

Rogers et al Company


NORTH

1120 Ft. from N, Line

_____ Ft. from S. Line

1120 Ft. from E. Line

Ft. from W. Line

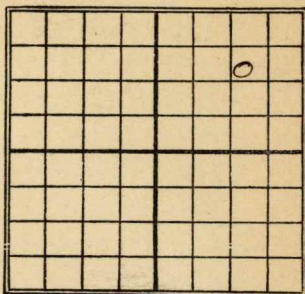

SOUTH

Date _____

REPORT

Date 9 2 2

 $5/21$

Dlg 400'

7/15

Abd 2180

Map No. 16 Kans Sec. 35 Twp. 25 R. 10Well No. 1 - ClarkRogers et al Company

Contractor

FIRST REPORT

SECTION PLAT

1120 Ft. from N. Line

Ft. from S. Line

1120 Ft. from E. Line

Ft. from W. Line

Location

Rig up

Drilling and Remarks:

deg - 400'

RECORD

Cased in, ft.

Sand

Gas

Oil

Total Depth

PRODUCTION

1st 24 hrs. Nat.

1st 24 hrs. after shot

Gas Cu. Ft.

Dry Hole

Abandoned

Date

MAY 21 1922

M. A. BENEAR

191

Scout

Map No. Bas 16 Sec. 35 Twp. 25 R. 10Well No. 1 ClarkRogers et al Company

Contractor

ABANDONED

SECTION PLAT

1120 Ft. from N. Line

Ft. from S. Line

1120 Ft. from E. Line

Ft. from W. Line

			0

Location

Rig up

Drilling and Remarks:

RECORD

Cased _____ in., _____ ft.

Sand _____

Gas _____

Oil _____

Total Depth _____

PRODUCTION

1st 24 hrs. Nat. _____

1st 24 hrs. after shot _____

Gas _____ Cu. Ft.

Dry Hole _____

Abandoned 2170

Date

JUL 15 1922

191

M. A. BENEAR

Scout