


Section 9 Township 27 Range 4E

Well No. #4 Anderson "A"

Company Sitrin Drlg.

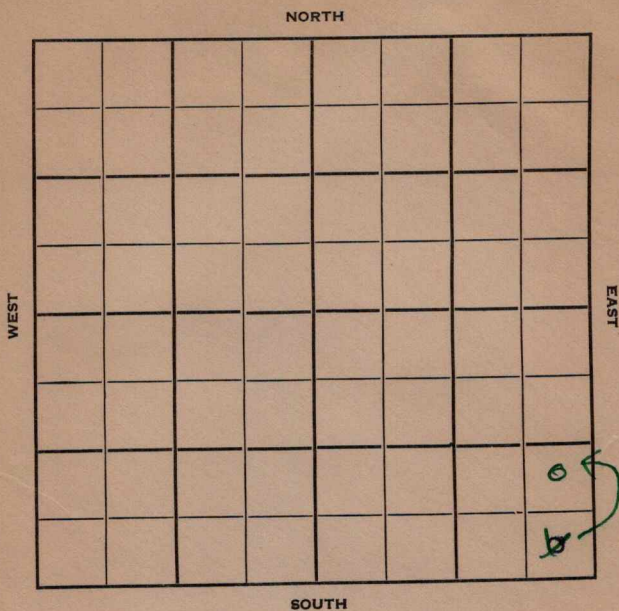

Butler

KANSAS

Sec. 9 Twp. 27 R. 1E

Well No. #4 Anderson "A" Farm

Sitrin Drlg. Company

Morrison Drlg. Contractor

Ft. from N. Line

1000

~~330~~

Ft. from S. Line

150

~~330~~


Ft. from E. Line

Ft. from W. Line

N 6 S E S E

SE $\frac{1}{4}$

~~SE SE SE~~

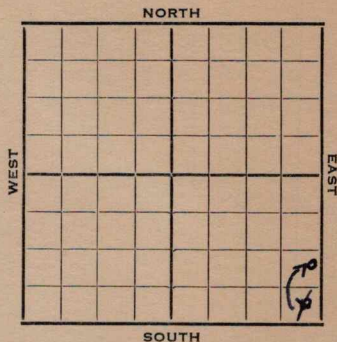

1952

Elev. 1247'

REPORT

10/22

Spud 10-16-52

8" @ 87

Drlg. 1973'

11/12

Spud 10-16-52

Oil Well

TD 2609'

8" @ 87

KC 1953, Arb. 2393,

5" @ 2451

TD 2609

CO to 2470 FU Oil

Comp. 20 bopd

COMPLETED

Sec. 9 (Blk. Twp.) 27 (Sur. Rge.) 4E Map No.

Well No. 4 Farm Anderson "A"

Elev.	Location	SE	SE	SE

FIRST REPORT

330 Ft. From E Line Quarter

1st. Report OCT 22 1952

Completion

Remarks

Morrison Drlg. - Contr.

Spudding Date 10-16-52

Drlg. Data

8" @ 87 drlg. 1973

Kansas

Map No. _____ Sec. 9 Twp. 27 R. 4EWell No. 4 Anderson "A"

Sitrin Drlg. _____ Company

CORRECTION

Contractor _____

NE SE SE

SECTION PLAT

_____ Ft. from N. Line

1000 Ft. from S. Line150 Ft. from E. Line

_____ Ft. from W. Line

Butler County

Location _____

Rig up _____

Drilling and Remarks:

Reported

SE SE SE

RECORD

Cased _____ in., _____ ft.

Sand _____

Gas _____

Oil _____

Total Depth _____

PRODUCTION

1st 24 hrs. Nat. _____

1st 24 hrs. after shot _____

Gas _____ Cu. Ft.

Dry Hole _____

Abandoned _____

Date

OCT 29 1952 19

J. G. McGEHEE

Scout

