

Sedgwick


KANSAS

SECTION 31 TOWNSHIP 28 RANGE 1E

WELL NO. #5 Slade

COMPANY Laura Jane

NORTH

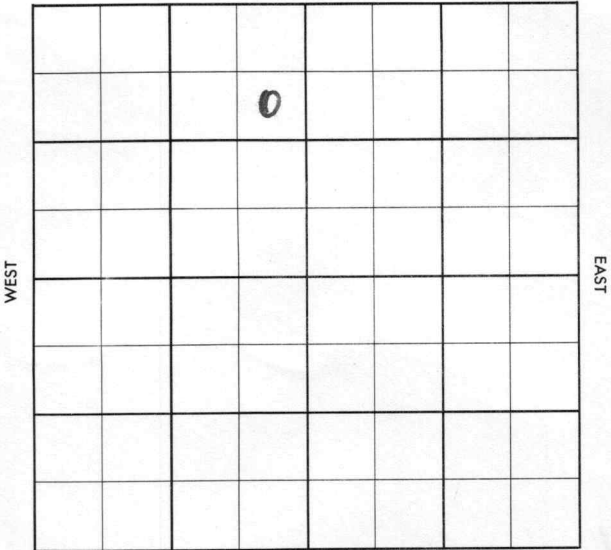

SOUTH

Sedgwick

KANSAS

SEC.	TWP.	R.
31	28	1E

WELL NO.

#5 Slade

FARM

COMPANY

Laura Jane

CONTRACTOR

Co. Tools

Gladys


Ft. from N. Line

Ft. from S. Line

Ft. from E. Line

Ft. from W. Line

SE NE NW

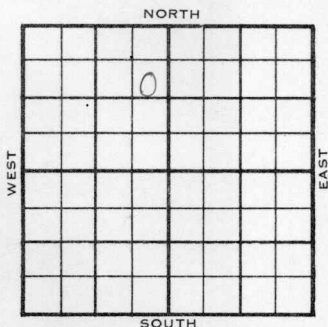

1956

ELEVATION

1268'

REPORT

4-18

Comm. 4-16-56
 10" @ 156 w/160
 WOC

5-16

5½" @ 3346
 3204 dd 3349½

6-20

P/ 115 bopd, 2% wtr.

Meas.

K.C. 2732', Chert. 3296', M. Li. 3327'
 M. Dolo 3343' TD 3346'

Vert.

K. C. 2647', Chert 3158', M. Li 3186',
 M. Dolo 3201', TD 3204'

COMPLETED

County Sedgwick Elev. _____
 Sec. 31 Twp. 28 Rge. 1E
 Company Laura Jane
 Farm Name Slade No. 5

TOPS	DEPTH	LOG	DATUM	Loc. in Sec.
Anh.				SE NE NW
T.P.				
H.				
Tr.				
Dg.				
BL.				
L.				Geol.
K.C.				Contr.
B.K.C.				Co. tools
Ce.				Pool
C.				Gladys
M.				
M.				
K.				
Mz.				
Ma.				
V.				
S.				
S.				
A.				
R.				
P.E.				
G.				
T.D.				

Date Comm. 4-16-56
10" @ 156/160 WOC

APR 5 4 1956

R. G.

29

County Sedwick Elev. 1268
 Sec. 31 Twp. 28 Rge. 11
 Company Laura Jane
 Farm Name Slade No. 5

TOPS	DEPTH	LOG	DATUM	Loc. in Sec.
Anb.	Meas.	Vert		SE 1/4 10
Ip.				(R19) 711 NL
H.				482 EL
Tr.				Target 550' FE
Dg.				1440 FNL
Bl.				of NW 4
L.				Geol.
K.C.	2732	2647		Contr.
B.K.C.				Co. tools
Ce.				Pool
C.				Clays
M. chert	3296	3158		COMPLETE
M. LI	3337	3186		
K. M. Dolo	3343	3201		
Mz.				
Mo.				
V.				
S.				
S.				
A.				
R.				
PE.				
G.				
TD.	3346	3204		

Date Comm. 4-16-56 JUN 2 0 1956

10" @ 156/160 100 APR 25 '56 ϕ 1559
 MAY 2 '56 ϕ 2851 MAY 9 '56 Pipe set
 MAY 16 '56 5 1/2 @ 3346 - 3204 DD
 3349 1/2 11 MAY 23 '56 MAY 29 '56 JUN 6 '56
 JUN 13 '56 JUN 20 '56 Ph P. 115
 Bopd 290 wtr.