


Map No. _____ Sec. 34 Twp. 25 R. 10
 Well No. 1- Town lot Farm _____
J.B. Murphy et al Company _____

NORTH

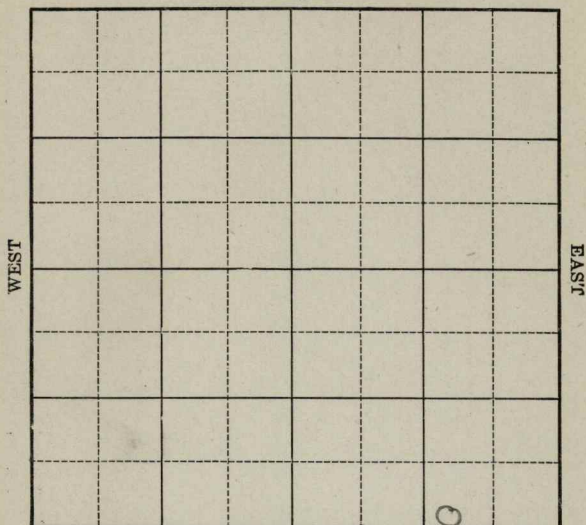

SOUTH

Location _____

Drilling Remarks _____

Rig Up _____

Drilling Remarks _____

RECORD

Cased _____ in. _____ ft.

Sand _____

Gas _____

Oil _____

Total Depth _____

PRODUCTION

1st 24 hrs. Nat. _____

1st 24 hrs. after shot _____

Gas _____ cu. ft.

Dry Hole _____

Abandoned _____

Map No. _____ Sec. 34 Twp. 25 R. 10
 Well No. 1- Town Lot Farm
J. B. Murphy et al Company

NORTH

_____ Ft. from N. Line


50 Ft. from S. Line

1120 Ft. from E. Line

_____ Ft. from W. Line

WEST

EAST

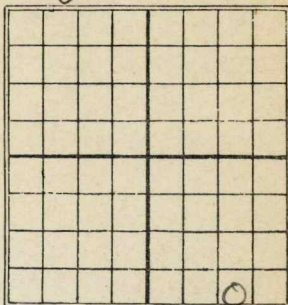

SOUTH

1927

Date

REPORT

9/4

Bldg Rig

10/6

aband. Loc

16 **KANSAS** Sec. 34 Twp. 25 R. 10
 Map No. _____
 Well No. 1 Town Rat
 J. B. Murphy et al Company
 _____ Contractor

FIRST REPORTS

_____ Ft. from N. Line
 50 _____ Ft. from S. Line
 1120 _____ Ft. from E. Line
 _____ Ft. from W. Line

SECTION PLAT

			6

Location _____
 Rig up _____
 Drilling and Remarks:

Block 53
 Entry Town Site

RECORD

Cased _____ in., _____ ft.
 Sand _____
 Gas _____
 Oil _____
 Total Depth _____

PRODUCTION

1st 24 hrs. Nat. _____
 1st 24 hrs. after shot _____
 Gas _____ Cu. Ft.
 Dry Hole _____
 Abandoned _____

Date

SEP 1 1927

CHAS. L. SHERWOOD

192

Scout

16 **KANSAS** Sec. 34 Twp. 25 R. 10

Well No. 1 Town Rat
J. B. Murphy et al Company

Contractor

COMPLETED

SECTION PLAT

_____ Ft. from N. Line

50 _____ Ft. from S. Line

1120 _____ Ft. from E. Line

_____ Ft. from W. Line

ABANDONED

			0

Location _____

Rig up _____

Drilling and Remarks:

RECORD

Cased _____ in., _____ ft.

Sand _____

Gas _____

Oil _____

Total Depth _____

PRODUCTION

1st 24 hrs. Nat. _____

1st 24 hrs. after shot _____

Gas _____ Cu. Ft.

Dry Hole _____

Abandoned _____

Date

OCT 6 - 1927

192

CHAS. L. SHERWOOD

Scout