

Well No. 3 Belson. Farm

Welch & McInnis Company

WEST

EAST

SOUTH

Rig Up

Drilling Remarks:

PRODUCTION

1st 24 hrs. Nat. _____

1st 24 hrs. after shot_____

Gas_____cu. ft.

Dry Hole _____

Abandoned _____

Map No. _____ Sec. 35 Twp. 25 R. 10

Well No. 3 Belson _____ Farm


Welch & M^cGinn's Company

1120 Ft. from N. Line

Ft. from S. Line

Ft. from E. Line

200 Ft. from W. Line

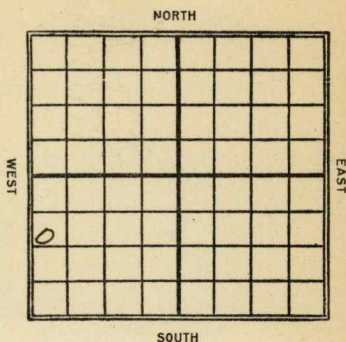

Date _____

REPORT

Date
1922

10/26	Alg. 300'
-------	-----------

1/24 Sand 1990-2021-201866.
Nat.

Map No. **KANSAS** ¹⁶ Sec. 35 Twp. 25 R. 10

Well No. 3 Bulson
Wilak & McGinnis Company

Contractor

FIRST REPORT

SECTION PLAT

1120 Ft. from N. Line
Ft. from S. Line
Ft. from E. Line
200 Ft. from W. Line

Location
Rig up
Drilling and Remarks:

300'

RECORD

Cased _____ in., _____ ft.
Sand _____
Gas _____
Oil _____
Total Depth _____

PRODUCTION

1st 24 hrs. Nat. _____
1st 24 hrs. after shot _____
Gas _____ Cu. Ft.
Dry Hole _____
Abandoned _____

Date

OCT 26 1922
M. A. BENEAR

Scout

Map No. **KANSAS** ¹⁶ Sec. **35** Twp. **25** R. **10**Well No. **3** *Rehough**Wish & McInnis* Company

Contractor

COMPLETED

SECTION PLAT

1120 Ft. from N. Line

Ft. from S. Line

Ft. from E. Line

200 Ft. from W. Line

<i>0</i>			

Location

Rig up

Drilling and Remarks:

Top Line 1985

RECORD

Cased _____ in., _____ ft.

Sand _____

Gas _____

Oil *1990-2021*Total Depth *2021*

PRODUCTION

1st 24 hrs. Nat. *20*

1st 24 hrs. after shot _____

Gas _____ Cu. Ft.

Dry Hole _____

Abandoned _____

Date

NOV 24 1991

M. A. BENEAR

Scout