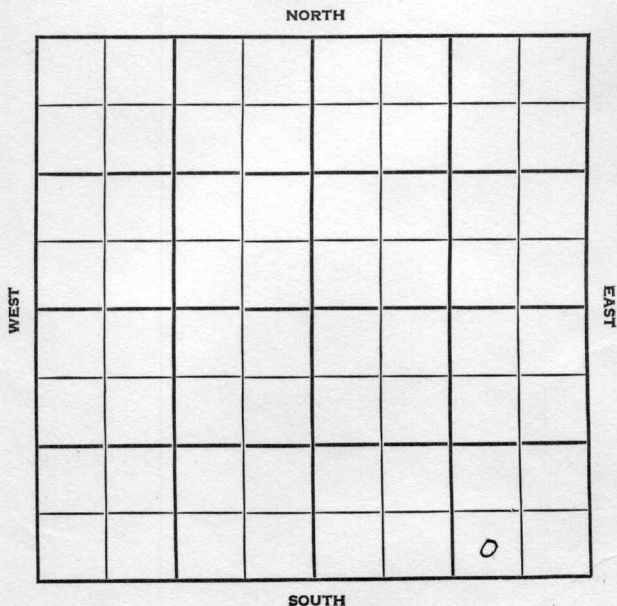


Section 31 Township 28S Range 1EWell No. #2 GuntherCompany H. & M. Drilling Co

O.W.W.O.

Sedgwick

KANSAS

SEC.	TWP.	R.
31	28	1E

WELL NO.

#2 Gunther

FARM

COMPANY

H & M Drlg.

CONTRACTOR

Co. Tools


Gladys

_____ Ft. from N. Line

_____ Ft. from S. Line

_____ Ft. from E. Line

_____ Ft. from W. Line

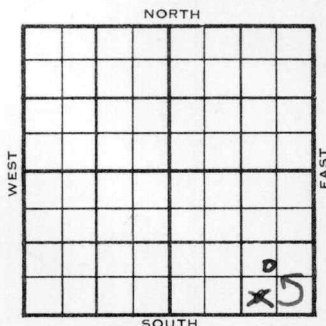

SE NW SESE
~~SW SE SE~~

	ELEVATION	REPORT
1955	1267'	

9/7 R U R

10/12 Comm 9-6-55
 8 5/8" @ 141
 KC 2675
 Ch 3184
 Dolo 3195
 B Miss 3206
 TD 3210
 DST 3197-3203 open 1 hr Rec 40' mud
 0/15" DST 3184-3210 open 1 hr 20 min
 330' GIP rec 70' hocm 150/20
 5 1/2" @ 3197/65 CO to 3210
 500 A
 Comp 95 bopd 20% wtr

COMPLETED

O.W.W.O.

1955
 11/23 OTD 3210' Miss dol. 3195'
 5" @ 3197 DD 3238' HFW PB 2835'
 4/2821-27 FU 100' wtr 10 min.
 4/2776-78 FU 250' wtr. 20 min
 HFW 12 hr. 5" @ 1923/25
 11-28 CO to 2400
 Comp. SWD well, Stal 2380'
 TD 3210'

ABANDONED

County Sedgwick Elev. _____
Sec. 31 Twp. 28 Rge. 1E
Company H & M Drilling
Farm Name Ganther No. 2

TOPS	DEPTH	LOG	DATUM	Loc. in Sec.
Anh.				SW SE SE
Tp.				
H.				
Tr.				
Dg.				
Bl.				
L.				
K.C.				Geol.
B.K.C.				Contr.
Ce.				Co. tools
C.				
M.				Pool
M.				
K.				Gladys
Mz.				
Me.				
V.				
S.				
S.				
A.				
R.				
Pe.				
G.				
T.D.				

Date Comm. RUR

FIRST REPORT
SEP 7 '55

No. _____
Sec. _____
T. _____
R. _____

County Sedgwick Elev. 1267
 Sec. 31 Twp. 28 Rge. 1E
 Company H & M Drilg.
 Farm Name Gunther No. 2

TOPS	DEPTH	LOG	DATUM	Loc. in Sec.									
Anh.				SW SE SE									
Tp.													
H.													
Tr.													
Dg.													
Bl.													
L.				Geol.									
K.C.	2675		1408	Contr.									
B.K.C.				Co. tools									
Ce.				Pool									
C.				Gladys									
M. <u>ch.</u>	3184		1917	<table border="1"> <tr><td></td><td></td><td></td></tr> <tr><td></td><td></td><td></td></tr> <tr><td></td><td></td><td></td></tr> </table>									
M. <u>dolo</u>	3195		1928										
K. <u>B. miss</u>	3206		1939										
Mz.													
Mq.													
V.													
S.													
S.													
A.													
R.													
Pf.													
G.													
T.D.	3210												

Date Comm. 9-6-55 OCT 12 1955

8 5/8" @ 141 DST 3197-3203 open 1 hr.

Rec. 40' mud 0/15" DST 3184-3210

open 1 hr. 20 min. 330' GIP rec. 70'

hocm 150/20" 5 1/2" @ 3197/65 CO to

3210 500 A Comp. 95 bopd 20% wtr.

O.W.W.O.

FORM 513 REV. SUNRAY

ONWO for SMD

County Sedgwick Elev. 1267 Co.
 Sec. 31 Twp. 28 Rge. 1E
 Company H & M Drlg.
 Farm Name Gunther No. 2

TOPS	DEPTH	LOG	DATUM	Loc. in Sec.
Anh.				SE NW SE SE
Tr.				
H.				
Tr.				
Dg.				
B.L.				
L.				
K.C.				Geol.
B.K.C.				Contr.
Ce.				
C. <u>1ss dol.</u>	<u>3195</u>			
M.				Pool
M.				<u>Gladys</u>
K.				
Mz.				
Mq.				
V.				
S.				
S.				
A.				
R.				
Pf.				
G.				
T.D.	<u>3210</u>			

NOV 23 '55
FIRST REPORT

Date Comm.

5" @ 3197 DD 3238 HFW DD 2835

4/ 2821-27 FU 100' wtr. 10 min.

4/ 2776-78 FU 250' wtr. 20 min.

HFW 12 hr. 5" @ 1923/25

OWWO for SWD

County Sedgwick Elev. 1267 Co.
 Sec. 31 Twp. 28 Rge. 1E
 Company H & M Drilg.
 Farm Name Gunther No. 2

TOPS	DEPTH	LOG	DATUM	Loc. in Sec.
Anh.				SE NW SE SE
Tr.				
Dg.				
B.L.				
L. <u>Stal</u>	<u>2380</u>		<u>1113</u>	Geol.
K.C.				Contr.
B.K.C.				
Ce.				
C.				
M. <u>Jolo</u>	<u>3195</u>		<u>1928</u>	Pool
M.				Gladys
K.				
Mz.				
Me.				
V.				
S.				
S.				
A.				
R.				
Pe.				
G.				
T.D.	<u>3310</u>			

DEC 28 1955

Date Comm.

5" @ 3197 DD 3238 HFW PB 2835

4/ 2821-27 FU 100' wtr. 10 min.

4/ 2776-78 FU 250' wtr. 20 min.

HFW 12 hr. 5" @ 1923/25 GO to 2400

Comp. SWD well

ABANDONED