


DX 78-1 Sedgwick

KANSAS
KANSAS

Section 31 Township 28 Range 1E

Well No. 3 Slade

Company Laura Jane

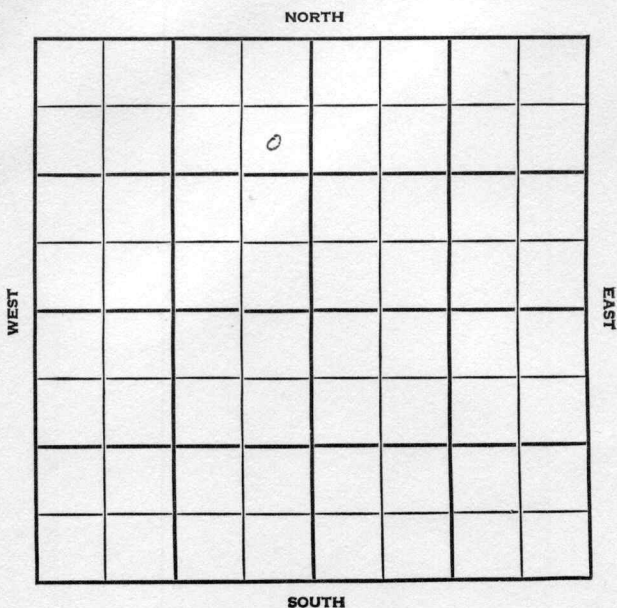

Sedgwick

KANSAS

SEC.	TWP.	R.
31	28	1 E

WELL NO.

3 Slade

FARM

COMPANY

Laura Jane

CONTRACTOR

Co. tools

Gladys Pool

990

Ft. from N. Line


Ft. from S. Line

330

Ft. from E. Line

Ft. from W. Line

SE NE NW

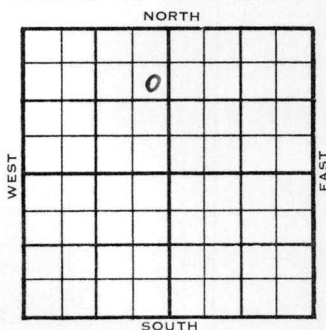

1955

ELEVATION

REPORT

4/27

Spud 4-23-54

8" @ 158

Drlg. 628'

6/8

5½" @ 3187 2½ boph Comp. F/107 bopd

Tops:	Depth	Datum
-------	-------	-------

And. Stal.	2305	1037
------------	------	------

KC	2649	1381
----	------	------

M. Lm	3170	1902
-------	------	------

M. dolo	3195½	1927
---------	-------	------

TD.	3199	
-----	------	--

COMPLETED

County **Sedgwick** State **Kansas**
Sec. **31** (Blk. **28**) (Sur. **1E**) Map No.
Operator **Laura Jane**
Well No. **3** Farm **Slade**
Elev. Location **SE NE NW**

990 Ft. From **N** Line **NW**330 Ft. From **E** Line Quarter1st. Report **APR 27 1955**

Completion

Remarks

Co. toolsSpudding Date **4-23-54**

Drlg. Data

Gladys Pool**8" @ 158 drlg. 628**

FABEN GILSTRAP

Farm Name Slade No. 3

Use.

No.

Sec.

T


TOPS	DEPTH	LOG	DATUM	Loc. in Sec.
Anh. <i>Stal.</i>	2305		1037	SE NE NW
TP.				
H.				
Tr.				
Dg.				
BL.				
L.				
K.C.	2649		1381	Geol.
B.K.C.				Contr.
Ce.				
C.				
M. <i>Lm</i>	3170		1902	Pool
M. <i>Dolo</i>	3195 1/2		1927	Gladys
K.				
Mz.				
Mq.				
V.				
S.				
S.				
A				
R.				
Pe.				
G.				
TP.	3199			