
DX 78-1

KANSAS

Section 32 Township 28 Range 1E

Well No. #3 Fager

Company O. A. Sutton

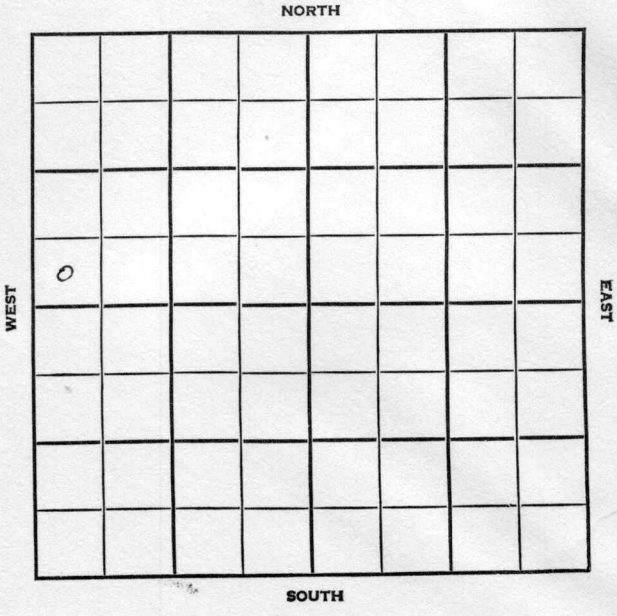

Sedgwick KANSAS

SEC.	TWP.	R.
32	28	1E

WELL NO.

3 Fager FARM

COMPANY

O. A. Sutton

CONTRACTOR

G & J

Gladys Pool


_____ Ft. from N. Line

330 Ft. from S. Line

_____ Ft. from E. Line

330 Ft. from W. Line

SW SW NW

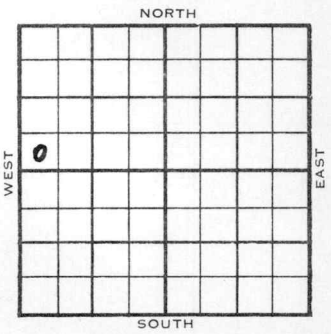

1955	ELEVATION 1265' REPORT
4/13	C&P
4/27	Spud 4-12-55 - D&A TD 3305' 8" @ 150' KC 2648', Cong. 3153', Miss 3272' DST 3273-85', opn 1 hr., rec. 25' mud, 460# Miss. 3300' TD 3305' D&A

ABANDONED

DX-78

FORM 275 FOR SALE BY KANSAS BLUE PRINT CO.


County Sedgwick State Kansas

Sec. 32 (Blk. Twp.) 28 (Sur. Rge.) 1E Map No.

Operator O. A. Sutton

Well No. 3 Farm Fager

Elev. Location SW SW NW

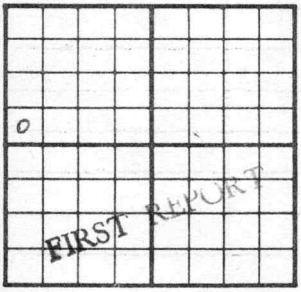

330 Ft. From S Line NW

330 Ft. From W Line Quarter

1st. Report APR 13 1955

Completion

Remarks G & J - Contr.

Spudding Date

Drlg. Data Gladys Pool

Cellar & pits

FABEN GILSTRAP

FORM 275 FOR SALE BY KANSAS BLUE PRINT CO.

County Sedgwick State Kansas

Sec. 32 (Blk. / Twp.) 28 (Sur. / Rge.) 1E Map No.

Operator O. A. Sutton

Well No. 3 Farm Fager

Elev. 1265 Location SW SW NW



330 Ft. From S Line NW

330 Ft. From W Line Quarter

1st. Report

Completion APR 2 7 1955

Remarks Gladys Pool

G & J - Contr.

Spudding Date 4-12-55

Drlg. Data D & A TD 3305

8" @ 150 KC 2648 Cong. 3153

Miss. 3272 DST 3273-85 open 1 hr.

Rec. 25' mud 460# Miss. 3300

TD 3305

D & A

FABEN GILSTRAP