


Map No. 75 Sec. 15 Twp. 24 R. 12

Well No. 1 H Lemming Farm
Larck Ebu Company

NORTH

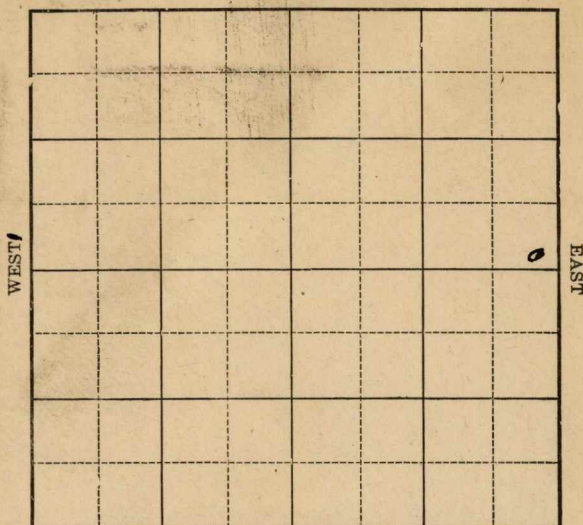

SOUTH

Location _____

Drilling Remarks:

Rig Up_____

Drilling Remarks:

RECORD

Cased _____ in. _____ ft.

Sand _____

Gas _____

Oil _____

Total Depth_____

PRODUCTION

1st 24 hrs. Nat._____

1st 24 hrs. after shot

Gas _____ cu. ft.


Dry Hole _____

Abandoned _____

Map No. 71 Sec. 15 Twp. 24 R. 12

Well No. 1 Flumming Farm
Lauck Ebal Company

 Ft. from N. Line
200 Ft. from S. Line
200 Ft. from E. Line
 Ft. from W. Line

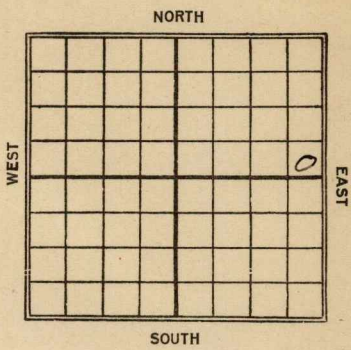

Date	REPORT
11/24	Top Line - 1706
	Top Pay - 1726
	to 1744 -
	50 bbls water

Map No. **KANSAS** 16 Sec. 15 Twp. 24 R. 12

Well No. 17 Lemmying

Lauck et al Company

Contractor

First Report

SECTION PLAT

COMPLETED

Ft. from N. Line

200 Ft. from S. Line

200 Ft. from E. Line

Ft. from W. Line

			0

Location

Rig up

Drilling and Remarks:

Tap Line 1706
 Tap pay. 1726
 to 1744
 50 lbs nat.

RECORD

Cased _____ in., _____ ft.

Sand _____

Gas _____

Oil _____

Total Depth _____

PRODUCTION

1st 24 hrs. Nat. _____

1st 24 hrs. after shot _____

Gas _____ Cu. Ft.

Dry Hole _____

Abandoned _____

Date

NOV 24 1923

M. A. BENEAR

192

Scout