
DX 78-1

Sedgwick KANSAS

Section 32 Township 28 Range 1E

Well No. 2 Fager

Company O. A. Sutton

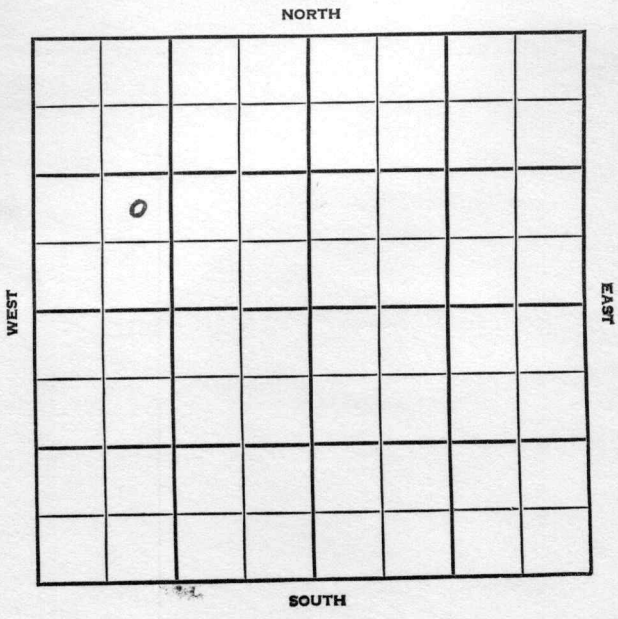

Sedgwick KANSAS

SEC.	TWP.	R.
32	28	1 E

WELL NO.

2 Fager FARM

COMPANY

O. A. Sutton

CONTRACTOR

Gabbert-Jones

Gladys Pool


_____ Ft. from N. Line

990 Ft. from S. Line

_____ Ft. from E. Line

990 Ft. from W. Line

NE SW NW

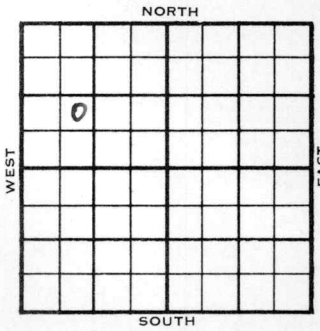

1955	ELEVATION	REPORT
3/23		Spud 3-16-55 8" @ 145 Drlg. 2450'

DX-78

FORM 275 FOR SALE BY KANSAS BLUE PRINT CO.

County Sedgwick State Kansas

Sec. 32 (Blk. Twp.) 28 (Sur. Rge.) 1E Map No.

Operator O. A. Sutton

Well No. 2 Farm Fager

Elev. Location NE SW NW



990 Ft. From S Line NW

990 Ft. From W Line Quarter

1st. Report MAR 23 1955

Completion

Remarks

Gabbert-Jones - Contr.

Spudding Date 3-16-55

Drlg. Data Gladys Pool

8" @ 145 drlg. 2450

FABEN GILSTRAP