
Sedgwick KANSAS

SECTION # 32 TOWNSHIP 28 RANGE 1E

WELL NO. #1 Hurley "B"

COMPANY Laura Jane

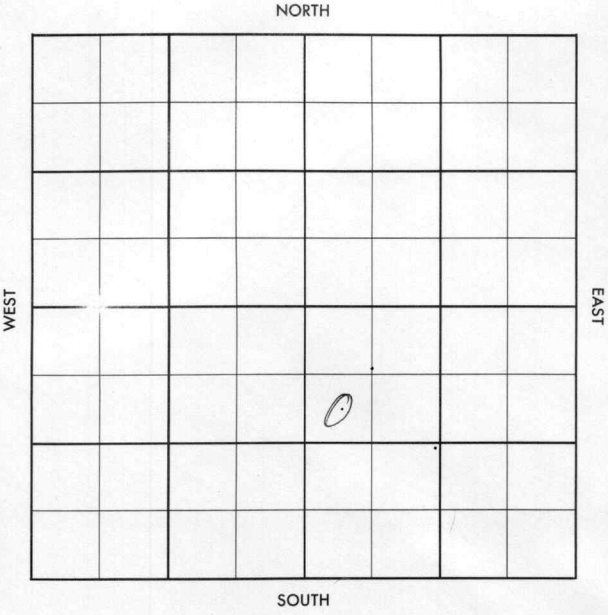

FORM 504-3 SUNRAY

FORM 513 SUNRAY

County Sedgwick Elev. Co.

Sec. 32 Twp. 28 Rge. 1E

Company Laura Jane

Farm Name Hurley "B" No. 1

TOPS	DEPTH	LOG	DATUM
Anh.			
Tp.			
H.			
Tr.			
Dg.			
B.L.			
L.			
K.C.			
B.K.C.			
Ce.			
C.			
M.			
M.			
K.			
Mz.			
Mo.			
V.			
S.			
S.			
A			
R.			
P€.			
G.			
T.D.			

Loc. in Sec. SW NW SE

1900' SL

2550' EL

Geol.

Contr. Co. tools Lse.

Pool Gladys

DEC 19 56

FIRST REPORT

No.

Date Comm. 12-11-56 Sec.

8" @ 167 drlg. 2070 T.

R.

FORM 519 SUNRAY

County Sedgwick Elev. 1261 DF

Sec. 32 Twp. 28 Rge. 1E

Company Laura Jane

Farm Name Hurley "B" No. 1

TOPS	DEPTH	LOG	DATUM
Anh.			
Tp.			
H.			
Tr.			
Dg.			
B.L.			
L.			
K.C.	2654		
B.K.C.			
Ce.			
C.			
M.	3143		
M. Polo	3152		
K.			
Mz.			
Mo.			
V.			
S.			
S.			
A			
R.			
Pe.			
G.			
TD	3240		

Loc. in Sec. SW NW SE

1900' SL

2550' EL

Geol.

Contr. Co. tools

Lse.

Pool Gladys

FEB 6 '57

COMPLETE

No.

Sec.

T.

R.

Date Comm. 12-11-56

8" @ 167 drlg. 2070 DEC 26 '56

cmd 3161-86½, 5½ @ 3240

JAN 2 '57 4/3222-24 w/ 40 BFPh

30% wtr T&R JAN 9 '57 POP

JAN 16 '57 P. 24 BOPD + 6 BWPD

JAN 23 '57 JAN 30 '57 WO POT. FEB 6 '57 X

st tst Ph P. 119 BOPD NB wtr

Miss PF 3222-24 RTD 3240