
KANSAS

DX 78-1 Sedgwick

Section 32 Township 28- Range 1E

Well No. #2 Hasler-Thiesing

Company Adair & Sutton

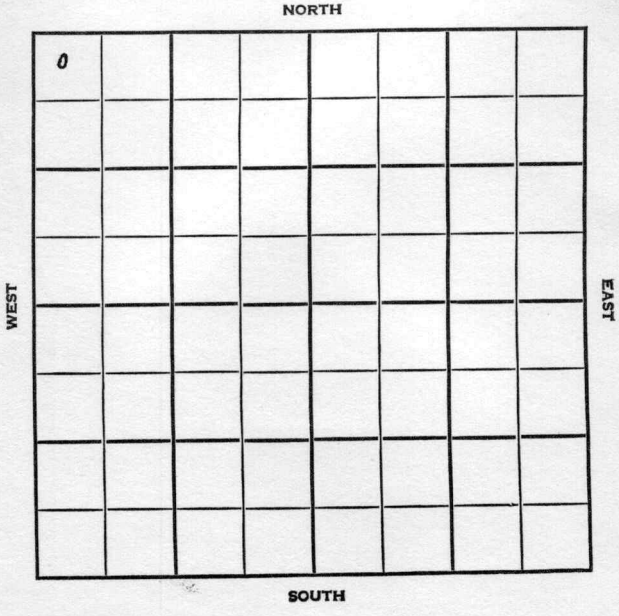

Sedgwick KANSAS

SEC.	TWP.	R.
32	28	1 E

WELL NO.

2 Hasler-Thiesing FARM

COMPANY

Adair & Sutton

CONTRACTOR

Gladys


210 Ft. from N. Line

Ft. from S. Line

Ft. from E. Line

325 Ft. from W. Line

NW NW NW

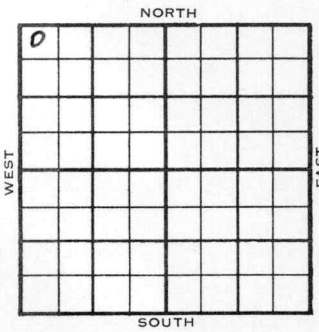

	ELEVATION	REPORT
1955	1265'	

6/15

Comm. 4-27-55
8" @ 164/135 5½" @ 3205/100
CO to 3209 S/3½ BOPH DD 3210
FU 1000' fluid 12 hr. S/3 BOPH
Comp. 105 BOPD
KC 2635' BKC 2831', ~~Chx~~ Ch. 3155
Lm 3163', Dolo 3203'
TD 3209'

FIRST REPORT

COMPLETED

DX-78

FORM 513 REV. SUNRAY

County Sedgwick Elev. 1265

Sec. 32 Twp. 28 Rge. 1E

Company Adair & Sutton

Farm Name Hasler-Thiesing No. 2

TOPS	DEPTH	LOG	DATUM
Anh.			
Tp.			
H.			
Tr.			
Dg.			
B.L.			
L.			
K.C.	2635		1370
B.K.C.	2831		1566
Ce.			
C. ch	3155		1890
M. Lm	3163		1898
M. Dolo	3203		1938
K.			
Mz.			
Mq.			
V.			
S.			
S.			
A			
R.			
P€.			
G.			
T.D.	3209		

Loc. in Sec. NW NW NW

210' NL

325' WL

Geol.

Contr.

Pool Gladys

FIRST REPORT

COMPLETE

Date Comm. 4-27-55

JUN 15 1955

8" @ 164/135 5½" @ 3205/100

CO to 3209 S/ 3½ boph DD 3210

FU 1000' fluid 12 hr. S/ 3 boph

Comp. 105 bopd

Co. Lse. No. Sec. T. R.