

KANSAS

Greenwood


Section 15 Township 24 Range 12E

Well No. 4 Fleming

Company Barnett & Hart

Virgil
NORTH

NORTH

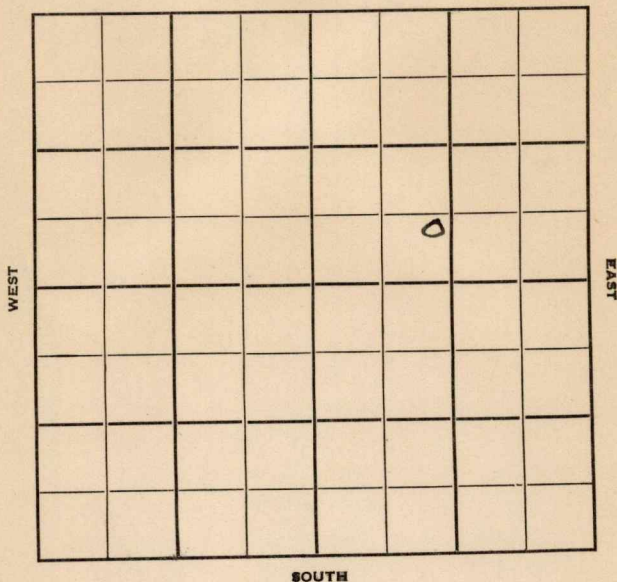

KANSAS

Greenwood

Sec. 15 Twp. 24 R. 12-E ✓

Well No. #4 Fleming Farm

Barnett & Hart Company


Virgil

 Ft. from N. Line

643 Ft. from S. Line

 Ft. from E. Line

1177 Ft. from W. Line

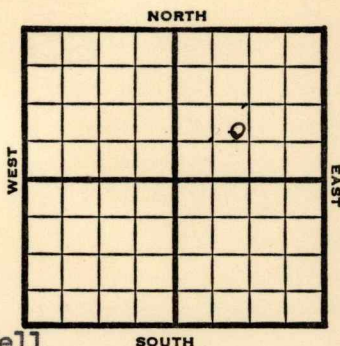

C EL SW NE Twin Well

1949	REPORT
4/27	10"@ 579' 8"@ 1273' Chat 1700' Miss 1708' 4"@ 1708' 1715 no shows. Twin Well
5/4	TD 1715' Miss 1708' A band ABANDONED

Map No. _____ Sec. 15 Twp. 24 R. 12E

Well No. 4 Fleming

Barnett & Hart Company

FIRST REPORT

Contractor

C E L S W N E

SECTION PLAT

_____ Ft. from N. Line

643 Ft. from S. Line

_____ Ft. from E. Line

1177 Ft. from W. Line

Greenwood County

Location _____

Rig up _____

Drilling and Remarks:

10" @ 579

8" @ 1273

Chat. 1700

Miss. 1708

4" @ 1708

1715 no shows

twin well

RECORD

Cased _____ in., _____ ft.

Sand _____

Gas _____

Oil _____

Total Depth _____

PRODUCTION

1st 24 hrs. Nat. _____

1st 24 hrs. after shot _____

Gas _____ Cu. Ft.

Dry Hole _____

Abandoned _____

Date

APR 27 1949 19

S. J. LEWIS

Scout

Map No. K 16 Sec. 15 Twp. 24 R. 12E

Well No. 4 Fleming

Barnett & Hart Company

ABANDONED Contractor

C E L SW NE


SECTION PLAT

 Ft. from N. Line

643 Ft. from S. Line

 Ft. from E. Line

1177 Ft. from W. Line

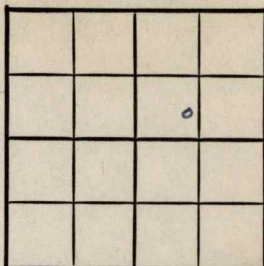

Greenwood County

Location

Rig up

Drilling and Remarks:

Mine 1708.

RECORD

Cased in., ft.

Sand

Gas

Oil

Total Depth 1215

PRODUCTION

1st 24 hrs. Nat.

1st 24 hrs. after shot

Gas Cu. Ft.

Dry Hole

Abandoned

Date

MAY 4 1949

19

S. J. LEWIS

Scout