
DX 78-1

Sedgwick KANSAS

Section 32 Township 28 Range 1 E

Well No. #2 Lohcamp

Company O. A. Sutton

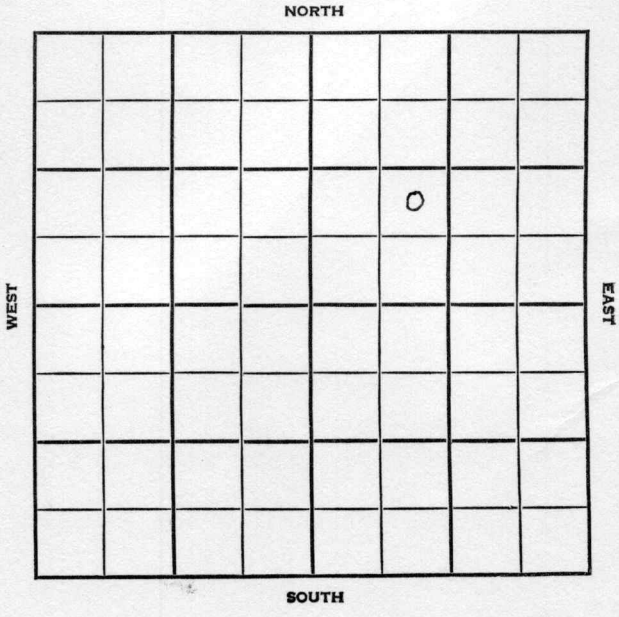

Sedgwick KANSAS

SEC.	TWP.	R.
32	28	1E

WELL NO.

#2 Lohcamp FARM

COMPANY

O. A. Sutton

CONTRACTOR

Gabbert-Jones

Gladys


_____ Ft. from N. Line

_____ Ft. from S. Line

_____ Ft. from E. Line

_____ Ft. from W. Line

NE SW NE

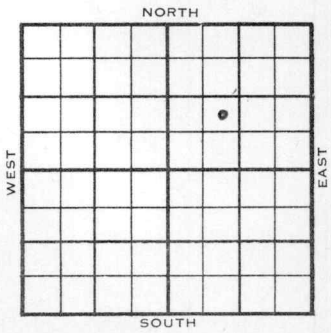

1955 ELEVATION 1266' REPORT FIRST REPORT

8/10 Comm: 8-5-55
8" @ 145/160 Drlg: 1290

10/26 Comm 8-5-55
8" @ 145/160
5 1/2" @ 3164

KC	2636
C Chert	3138
Chert	3141
Lime	3145
M dolo	3164
TD	3186

DD 3189 3000A F/5 boph Comp
F/446 bopd

COMPLETED

DX-78

FORM 513 REV. SUNRAY

County Sedgwick Elev.

Sec. 32 Twp. 28 Rge. 1E

Company O. A. Sutton

Farm Name Lohcamp No. 2

TOPS	DEPTH	LOG	DATUM
Anh.			
Tp.			
H.			
Tr.			
Dg.			
B.L.			
L.			
K.C.			
B.K.C.			
Ce.			
C.			
M.			
M.			
K.			
Mz.			
Mo.			
V.			
S.			
S.			
A			
R.			
P€.			
G.			
T.D.			

Loc. in Sec. NE SW NE

Geol.

Contr. Gabbert-Jones

Lse.

Pool Gladys

AUG 1 C

FIRST REPORT

Co.

No.

Sec.

T.

R.

Date Comm. 8-5-55

8" @ 145/160 drlg. 1290

FORM 513 REV. SUNRAY

County Sedgwick Elev. 1266

Sec. 32 Twp. 28 Rge. 1E

Company O. A. Sutton

Farm Name Lohcamp No. 2

TOPS	DEPTH	LOG	DATUM
Anh.			
Tp.			
H.			
Tr.			
Dg.			
B.L.			
L.			
K.C.	2636		1370
B.K.C.			
Ce.			
C. Chert	3138		1872
M. Chert	3141		1875
M. lime	3145		1879
K. mdolo	3164		1898
Mz.			
Mq.			
V.			
S.			
S.			
A			
R.			
P€.			
G.			
T.D.	3186		

Loc. in Sec. NE SW NE

Geol.

Contr. Gabbert-Jones

Pool Gladys

COMPLETE

Date Comm. 8-5-55 OCT 26 1955

8" @ 145/160 5½" ¼ 3164 DD 3189

3000 A F/ 5 boph Comp. F/ 446 bopd

Co. Lse. No. Sec. T. R.