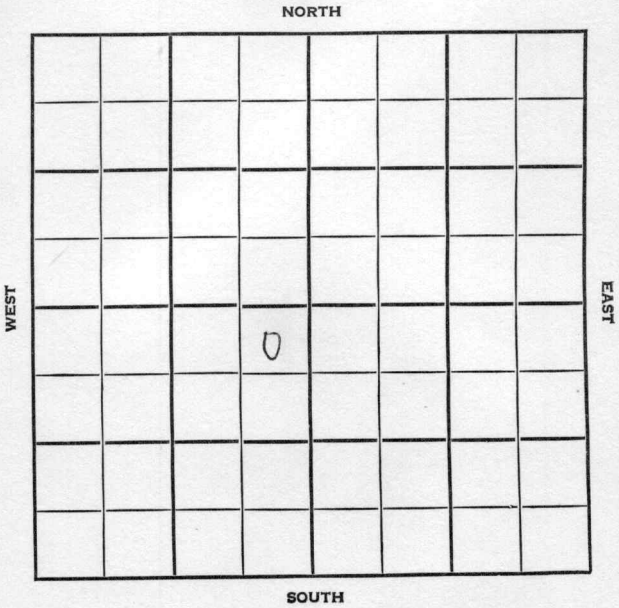


Sedgwick KANSAS

Section 32 Township 28 Range 1EWell No. 3 NelsonCompany O. A. Sutton

Sedgwick

KANSAS

SEC.	TWP.	R.
32	28	1 E

WELL NO.

3 Nelson

FARM

COMPANY

O. A. Sutton

CONTRACTOR

Murfin


Gladys

Ft. from N. Line

Ft. from S. Line

Ft. from E. Line

Ft. from W. Line

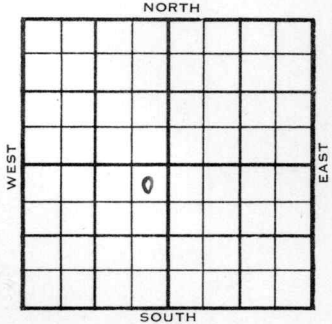

NE NE SW

ELEVATION

REPORT

1955

1262'

7/13

Comm. 5-27-55

8" @ 162/150 5 1/2" @ 3184 CO to 3198

S/3 BOPH

Comp. 105 BOPD

KC 2645', M. Ch 3155', M. Lm 3172'

M. Dolo 3181'

TD 3198'

FIRST REPORT

COMPLETED

County Sedgwick Elev. 1262
Sec. 32 Twp. 28 Rge. 1E
Company O. A. Sutton
Farm Name Nelson No. 3

TOPS	DEPTH	LOG	DATUM
Anh.			
TP.			
H.			
Tr.			
Dg.			
BL.			
L.			
K.C.	2645		1383
B.K.C.			
Ce.			
C.			
M. ch	3155		1893
M. Im	3172		1910
M. Dolo	3181		1919
Mz.			
Mq.			
V.			
S.			
S.			
A.			
R.			
PE.			
G.	52		1922
TD.	3198		1936

Loc. in Sec. NE NE SW

Geol. _____

Contr. _____

Murfin

Pool _____

Gladys

FIRST REPORT
COMPLETE

JUL 13 1955

Date Comm. 5-27-55

8" @ 162/150 5 1/2" @ 3184 CO to 3198

S/ 3 boph Comp. 105 bopd

Co.

Lse.

No.

Sec.

T.

R.