
Sedgwick KANSAS

SECTION 32 TOWNSHIP 28 RANGE 1 E

WELL NO. #3 Lohkamp

COMPANY O. A. Sutton

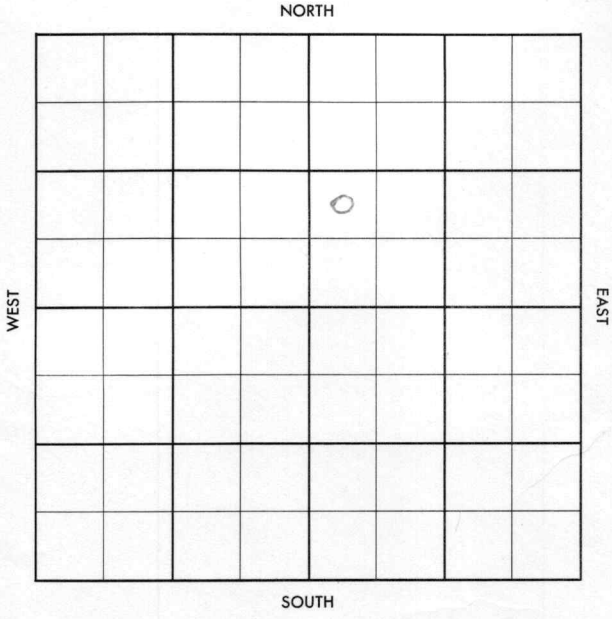

FORM 504-3 SUNRAY

Sedgwick KANSAS

SEC.	TWP.	R.
32	28	1E

WELL NO.

#3 Lohkamp FARM

COMPANY

O.A. Sutton

CONTRACTOR

Murfin

Gladys


_____ Ft. from N. Line

1190 Ft. from S. Line

_____ Ft. from E. Line

460 Ft. from W. Line

NW SW NE

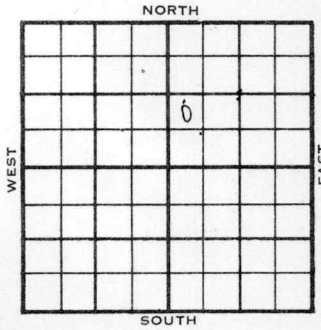

1955	ELEVATION ## 1265 REPORT
12-14	Comm. 12-13-55 8" @ 154/160 WOC
1956	
2-1	5½" @ 3282 CO to 3294 2000 A F/ 39 boph Comp. F/ 606 bopd Vertical M. Chert 3138 M. Lm. 3150 M. Dolo 3188 TD 3294' COMPLETED

DX-78

FORM 513 REV. SUNRAY

County Sedgwick Elev.

Sec. 32 Twp. 28 Rge. 1E

Company O. A. Sutton

Farm Name Lohkamp No. 3

TOPS	DEPTH	LOG	DATUM
Anh.			
Tp.			
H.			
Tr.			
Dg.			
B.L.			
L.			
K.C.			
B.K.C.			
Ce.			
C.			
M.			
M.			
K.			
Mz.			
Mq.			
V.			
S.			
S.			
A			
R.			
P€.			
G.			
T.D.			

Loc. in Sec. NW SW NE

1190' SL

460' WL

twin

Geol.

Contr. Murfin

Pool Gladys

DEC 14 '55

FIRST REPORT

Date Comm. 12-13-55

8" @ 154/160 WOC

Co. Lse. No. Sec. T. R.

FORM 513 REV. SUNRAY

County Sedgwick Elev. 1265

Sec. 32 Twp. 28 Rge. 1E

Company O. A. Sutton

Farm Name Lohkamp No. 3

TOPS	DEPTH	LOG	DATUM
Anh.	Vertical		
Tp.			
H.			
Tr.			
Dg.			
B.L.			
L.			
K.C.			
B.K.C.			
Ce.			
C.			
M. Chert	3138		1873
M. Lm	3150		1885
K. M. dolo	3188		1923
Mz.			
Mo.			
V.			
S.			
S.			
A			
R.			
P€.			
G.			
T.D.	3294		

Loc. in Sec. NW SW NE


1190' SL

460' WL

Geol.

Contr. Murfin

Pool Gladys

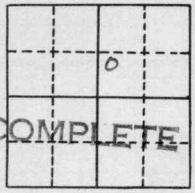

Date Comm. 12-13-55 FEB 1 1956

8" @ 154/160 5½" @ 3282 CO to 3294

2000 A F/ 39 boph Comp. F/ 606 bopd

Co. Lse. No. Sec. T. R.