


DX 78-1 Sedgwick

KANSAS

Section 32 Township 28 Range 1E
Well No. #1 Sites Unit
Company O. A. Sutton

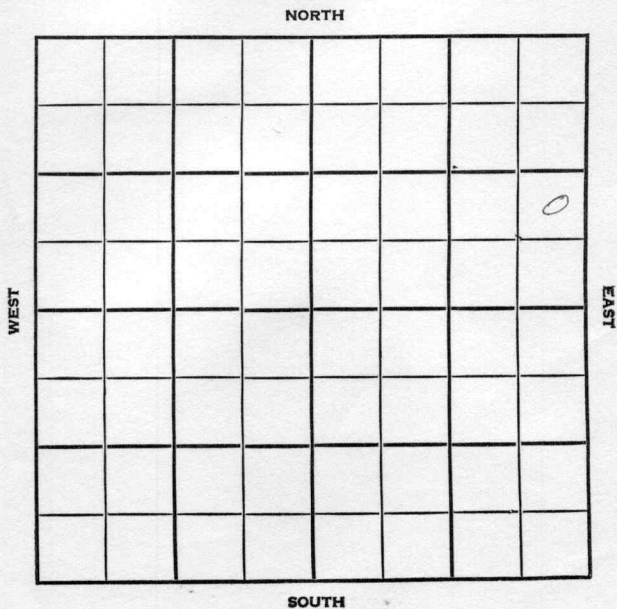

Sedgwick

KANSAS

SEC.	TWP.	R.
32	28	1E

WELL NO.

#1 Sites Unit

FARM

COMPANY

O.A. Sutton

CONTRACTOR

Renfro

Gladys

Ft. from N. Line


1090'

Ft. from S. Line

600

Ft. from E. Line

Ft. from W. Line

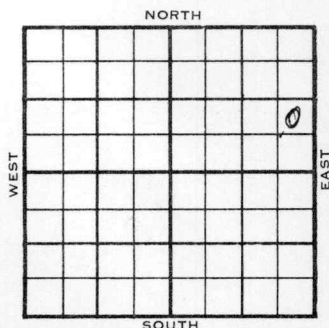

NE SE NE

1956

ELEVATION
1269 KB

REPORT

3-21

Comm. 3-19-56

8" @ 132/135

Drlg. 1960

6-13

5½" @ 3179/100

CO to 3199

1 boph FU 1200' oil 10 hr.

2500 A

Comp. 21 bopd 20 bw.

K.C. 2640', Chart, 3167', Lm. 3172',

M. Dol 3179'

TD 3199'

COMPLETED

County Sedgwick Elev. 1269 KB
 Sec. 32 Twp. 28 Rge. 1E
 Company O. A. Sutton
 Farm Name Sites Unit No. 1

TOPS	DEPTH	LOG	DATUM	Loc. in Sec.
Anh.				NE SE NE
Tp.				1090' SL
H.				600' EL
Tr.				Geol.
Dg.				Contr.
Bl.				Renfro
L.				Pool
K.C.				Gladys
B.K.C.				
Ce.				
C.				
M.				
M.				
K.				
Mz.				
Me.				
V.				
S.				
S.				
A.				
R.				
Pe.				
G.				
TD.				

			0
FIRST REPORT			
MAR 21 '56			

Date Comm. 3-19-56
8" @ 132/135 drlg. 1960

Co.

Lse.

No.

Sec.

T.

R.

County Sedgewick Elev. 1269 KB
 Sec. 32 Twp. 28 Rge. 1E
 Company O. A. Sutton
 FarmName Sites Unit No. 1

TOPS	DEPTH	LOG	DATUM
Anh.			
Tr.			
H.			
Tr.			
Dg.			
Bl.			
L.			
K.C.	<u>2640</u>		
B.K.C.			
Ce.			
C.			
M.	<u>Chat 3167</u>		
M.	<u>3172</u>		
K.	<u>m. dol. 3179</u>		
Mz.			
Mq.			
V.			
S.			
S.			
A.			
R.			
PE.			
G.			
T.D.	<u>3199</u>		

Loc. in Sec. _____

NE SE NE

1090' SL

600' EL

Geol. _____

Contr. _____

Renfro

Pool

Gladys

JUN 13 '56

COMPLETE

Date Comm.

3-19-56

8" @ 132/135 5 $\frac{1}{2}$ " @ 3179/100

CO to 3199 1 boph FU 1200' oil 10 hr.

2500 A Comp. 21 bopd 20bw