

SECTION 32 TOWNSHIP 28 RANGE 1EWELL NO. #5 Wards ~~45th~~ AdditionCOMPANY Raymond & Adair

NORTH

					0		

WEST

EAST

SOUTH

Sedgwick

KANSAS

SEC.	TWP.	R.
32	28	1E
WELL NO.		

#5 Wards 4th Addition

FARM

COMPANY

Raymond & Adair

CONTRACTOR

Adair

447

Ft. from N. Line


Ft. from S. Line

Ft. from E. Line

777

Ft. from W. Line

NE NW NE

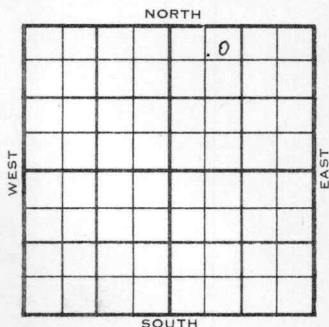

1956

ELEVATION

1267'

REPORT

4-4

Comm. 3-30-56

10" @ 165

Drlg. 1220

6-13

crd. 3264-96 Full Rec.

crd. 3164-95 ~~xxxx~~

5 1/2" 3296 Vert. @ 3195

Mict

Measured: 20/3264-70, 20/ 3177-82
16/3288-92Vertical: 20/ 3164-70, 20/ 3177-82,
16/3188-92

F/W 120 bo no/w 12 hrs.

WOPT

WOPT

Phy. 332 / tr. W. G. 93

Stall 2351', K.C. 2701', Cherty 3238',

LI. 3254', Dolo 3261-70' (Measure)

Stall 2297', K.C. 2629', Cherty 3110',

LI. 3153', Dolo 3161', (Vertical)

TD 3296 (M)

TD 3195 (V)

COMPLETED

County Sedgwick Elev. _____ Co.
 Sec. 32 Twp. 8B Rge. 1E
 Company Raymond & Adair
 Farm Name Wards 1/4th Addition No. 5

TOPS	DEPTH	LOG	DATUM	Loc. in Sec. _____	Lse.
Anh.				NE NW NE	
TP.				777' WL	
H.				147' NL	
Tr.				Geol. _____	
Dg.				Contr. _____	
Bl.				Adair	
L.				Pool _____	
M.C.					
B.K.C.					
Ce.					
C.					
M.					
M.					
K.					
Mz.					
Me.					
V.					
S.					
S.					
A					
R.					
Pe.					
G.					
TD.					

		0
FIRST REPORT		
		4-56

Date Comm. 3-30-56
10" @ 165 drlg. 1220

APR 1 0 1956

R. G. R.

County Secord Elev. 1267
 Sec. 32 Twp. 28 Rge. 1E
 Company Raymond Adair
 Farm Name Wards lth Addition No. 5

TOPS	DEPTH	LOG	DATUM	Loc. in Sec.
Anh.	Measure	vertical		NE NW NE
Tp. <u>stall</u>	<u>2351</u>	<u>2297</u>		777' WL
H.				777' WL
Tr.				
Dg.				
Bl.				
L.				
K.C.	<u>2701</u>	<u>2629</u>		Geol.
B.K.C.				Contr.
Ce.				Adair
C. <u>cherty</u>	<u>3238</u>	<u>3140</u>		
M. <u>LI</u>	<u>3254</u>	<u>3153</u>		
M. <u>Dolo</u>	<u>3261-70</u>	<u>3161</u>		Pool
K.				
Mz.				
Ma.				
V.				
S.				
S.				
A.				
R.				
Pe.				
G.				
T.D.	<u>3296</u>	<u>3195</u>		

COMPLETE

JUN 13 '56

Date Comm. 3-30-56

10" @ 165 ft. 1220' APR 11 '56 1/2 2290

APR 18 '56 2900 APR 25 '56 crd 3264

-96 Full Rec. crd 3164-95

5 1/2 3296 vert. @ 3195 MICT MAY 2 '56

{ 20' Measured 1/3264-70 29' 3277-82 16' 3288-92

{ 29' vertical 1/3164-70 27' 3177-82 16' 3188-92

Flw 120 B0 170/w 12 hrs

MAY 9 '56 MAY 15 '56 MAY 23 '56 MAY 29 '56 JUN 6 '56

WOPT JUN 13 '56 Phy 332 + K. W. G. 43"