
Sedgwick KANSAS

SECTION 33 TOWNSHIP 28 RANGE 1E

WELL NO. #1 Wheeler

COMPANY O. A. Sutton

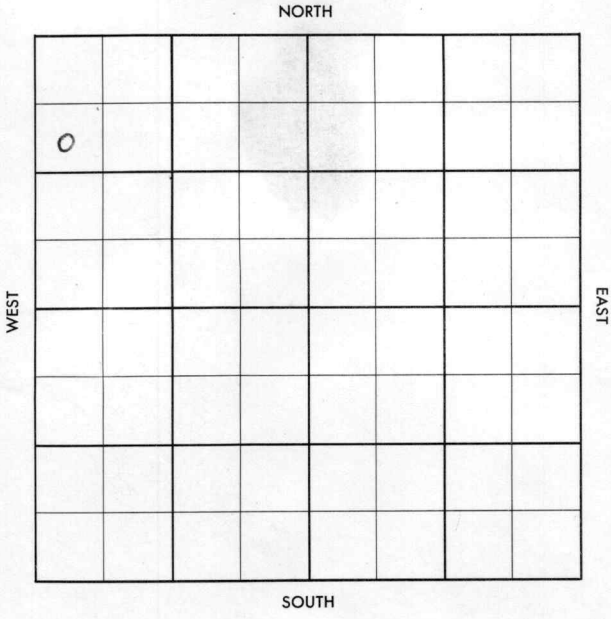

FORM 504-3 SUNRAY

Sedgwick KANSAS

SEC.	TWP.	R.
33	28	1E

WELL NO.

#1 Wheeler FARM

COMPANY

O.A. Sutton

CONTRACTOR

Renfro

Gladys


_____ Ft. from N. Line

_____ Ft. from S. Line

_____ Ft. from E. Line

_____ Ft. from W. Line

SW NW NW

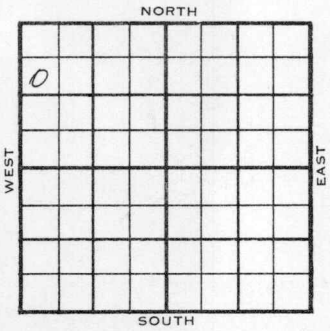

1956	ELEVATION 1266'	REPORT
5-2		Comm. 4-28-56
		8" @ 135 w/136
		Drlg. 2198
5-9		5½" @3215 w/100
5-16		CO 24/ 3161-63
		Swabbed 28 bo
		Frac
		Putting on pump
5-23		No report
5-29		" "
6-6		" "
6-13		" "
6-20		P/ dry
		D & A
		K. C. 2635', M. 3153', Dolo 3159'
		TD 3219' ABANDONED

DX-78

FORM 513 SUNRAY

County Sedgwick Elev. 1266

Sec. 33 Twp. 28 Rge. 1E

Company O. A. Sutton

Farm Name Wheeler No. 1

TOPS	DEPTH	LOG	DATUM
Anh.			
Tp.			
H.			
Tr.			
Dg.			
B.L.			
L.			
K.C.			
B.K.C.			
Ce.			
C.			
M.			
M.			
K.			
Mz.			
Mq.			
V.			
S.			
S.			
A			
R.			
P€.			
G.			
T.D.			

Loc. in Sec. SW NW NW

Geol.

Contr. Renfro

Pool Gladys



Date Comm. 4-28-56

8" @ 135/136 drlg. 2192

Co. Lse. No. Sec. T. R.

FORM 513 SUNRAY

County Sedgwick Elev. 1266 Co.

Sec. 33 Twp. 28 Rge. 1E

Company O. A. Sutton

Farm Name Wheeler No. 1

TOPS	DEPTH	LOG	DATUM
Anh.			
T.p.			
H.			
Tr.			
Dg.			
B.L.			
L.			
K.C.	2635		
B.K.C.			
Ce.			
C.			
M.	3153		
M. Dolo	3159		
K.			
Mz.			
Mo.			
V.			
S.			
S.			
A			
R.			
P€.			
G.			
T.D.	3219		

Loc. in Sec. SW NW NW

Geol.

Contr. Renfro

Lse.

Pool Gladys

o

ABANDONED

No.

Date Comm. 4-28-56 JUN 20 1956

Sec.

8" @ 135/136 drlg. 2192 MAY 9 '56 5½ ©

T.

3215/100 MAY 15 '56 CO 24/3161-63

½ & 28 BO Frac POP MAY 23 '56

MAY 29 '56 JUN 6 '56 JUN 13 '56 JUN 20 '56 P. dry

R.

O & G